

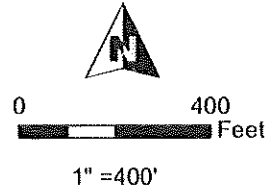


**T41S R13W, WM
CURRY COUNTY, OR**

- POD - Spring #1
- Storage Tanks
- Pipeline
- ▨ POU - Domestic Expanded
- Section
- Quarter Quarter
- Tax Lot

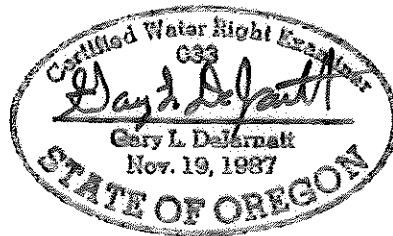

POD (Spring #1) Location:
50' S, 1340' E of NW Cor Sec 10

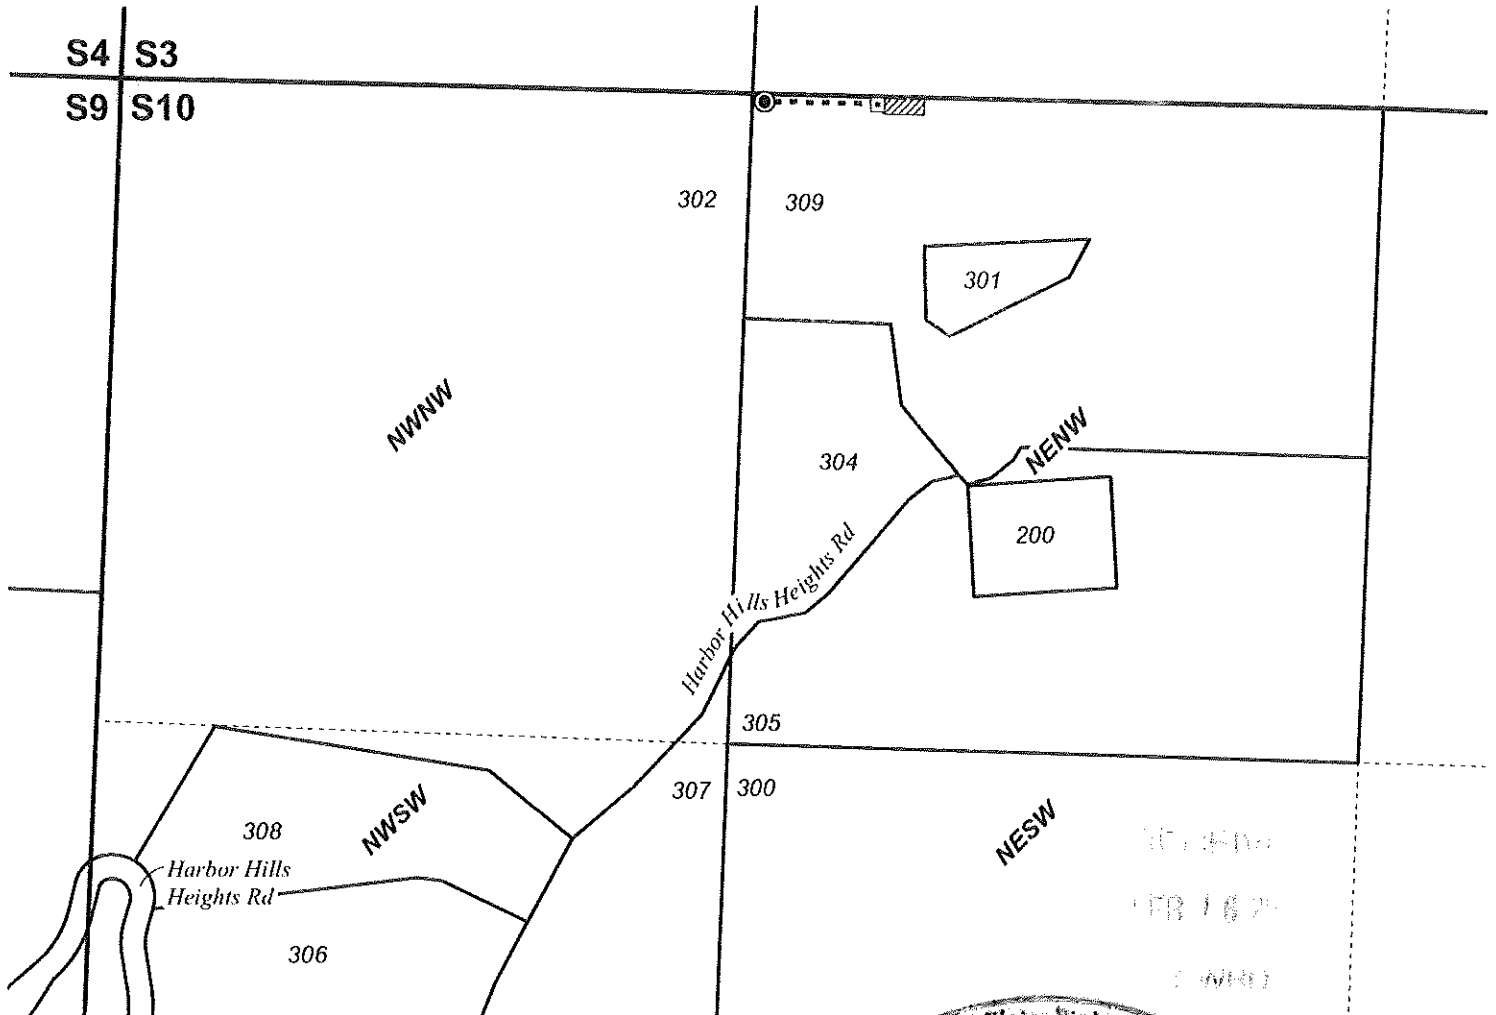

RENEWAL DATE 12/31/2023



**Claim of Beneficial Use Map
Wissler**

Ap S-88082 Permit S-55073

Project #23058
Date: 12/13/2023

This map is not intended
to provide legal dimensions
or locations of property
ownership lines.

WATER RIGHT SERVICES, LLC
PO BOX 1830, BEND, OR 97709
WWW.OREGONWATER.US CCB # 197121
johnshort@usa.com 541-389-2837