

APPLICATION NO. S 86655
PERMIT NO. S 54379
TOWNSHIP 4 SOUTH / RANGE 2 WEST / SECTION 1

This map is not intended to provide legal dimensions or locations of property ownership lines.



T 3S / R 2W

T 4S / R 2W

SW Wilsonville Rd

SECTION 1
NW 1/4 NW 1/4
(SEE DETAIL BELOW)

919 ft

261 ft

WATER

WILLAMETTE RIVER


Received
JUN 20 2025
OWRD

WATER SYSTEM DETAIL



PLACE OF USE


R4201 02100

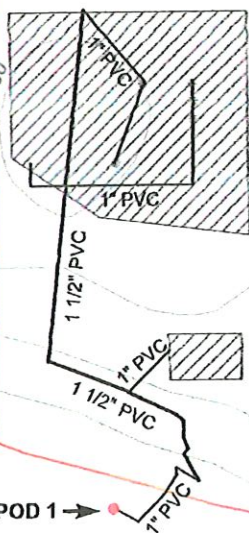

FISH SCREEN AT INLET 2' BELOW POD 1

Legend

- POINT OF DIVERSION 1/ METER
- ROAD
- ELEVATION CONTOUR
- TOWNSHIP LINE
- SECTION LINE
- YAMHILL CO. TAX LOT

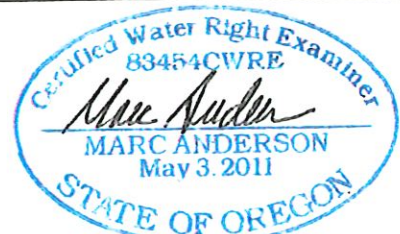

Expires 12/31/25

0 200 400 800 1,200 1,600 Feet