


LEGEND

- Point of Diversion (POD)
- △ Staff Gage
- South Airport Pond #1
- All Other Features
- Tax Lot
- Watercourse
- Waterbody

Claim of Beneficial Use Map Sarbanand Enterprises, LLC. Application R-88417; Permit R-15271

township 4 South, Range 4 West (W.M.)

CERTIFIED WATER RIGHTS EXAMINER STAMP

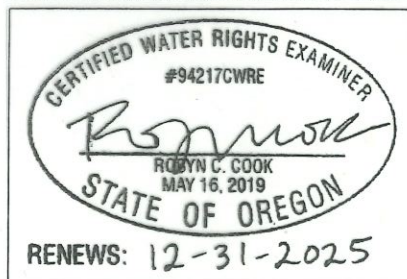

POA LOCATION DESCRIPTION

Dam Outlet
Located 195 feet South and 2,525 feet East from the NW corner of Section 35, Township 4 South, Range 4 West (W.M.)
(-123.1465140, 45.1857144)



0 660 1,320
1 inch = 1,320 feet



DISCLAIMER

This map was prepared for the purpose of identifying the location of a water right only and it is not intended to provide legal dimensions or location of property ownership lines.

Date: October 3, 2024
Data Sources: BLM, ESRI, OWRD, USGS