


LEGEND

- Point of Diversion (POD)
- Staff Gage
- South Airport Pond #2
- All Other Features
 - Tax Lot
 - Donation Land Claim (DLC)
 - Watercourse
 - Waterbody

Claim of Beneficial Use Map
Sarbanand Enterprises, LLC.
Application R-88418; Permit R-15272
 Township 4 South, Range 4 West (W.M.)

CERTIFIED WATER RIGHTS EXAMINER STAMP

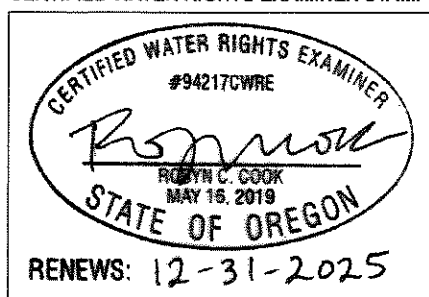

POD LOCATION DESCRIPTION

Dam Outlet
 Located 1,150 feet South and 1,570 feet West from the NE corner of Section 35, Township 4 South, Range 4 West (W.M.)
 (-123.14138637, 45.182641819)

DISCLAIMER
 This map was prepared for the purpose of identifying the location of a water right only and it is not intended to provide legal dimensions or location of property ownership lines.

Date: October 29, 2024
 Data Sources: BLM, ESRI, OWRD, USGS

