


#### LEGEND

- |                          |                       |                           |
|--------------------------|-----------------------|---------------------------|
| Point of Diversion (POD) | Conveyance Line       | Tax Lot                   |
| Fish Screen              | South Airport Pond #1 | Donation Land Claim (DLC) |
| Meter                    | South Airport Pond #2 | Watercourse               |
| Place of Use (POU)       |                       | Waterbody                 |

### Claim of Beneficial Use Map Sarbanand Enterprises, LLC. Application S-88591; Permit S-55163

Township 4 South, Range 4 West (W.M.)

#### CERTIFIED WATER RIGHTS EXAMINER STAMP

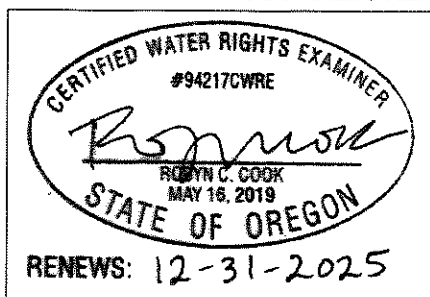

#### POA LOCATION DESCRIPTION

**POD South Airport Pond #1**  
Located 140 feet South and 2,915 feet West from the NE corner of Section 35, Township 4 South, Range 4 West (W.M.)  
(-123.146701, 45.185302)  
**POD South Airport Pond #2**  
Located 1,500 feet South and 1,425 feet West from the NE corner of Section 35, Township 4 South, Range 4 West (W.M.)  
(-123.140971, 45.182801)

#### DISCLAIMER

This map was prepared for the purpose of identifying the location of a water right only and it is not intended to provide legal dimensions or location of property ownership lines.

Date: October 29, 2024

Data Sources: BLM, ESRI, OWRD, USGS

