


copy

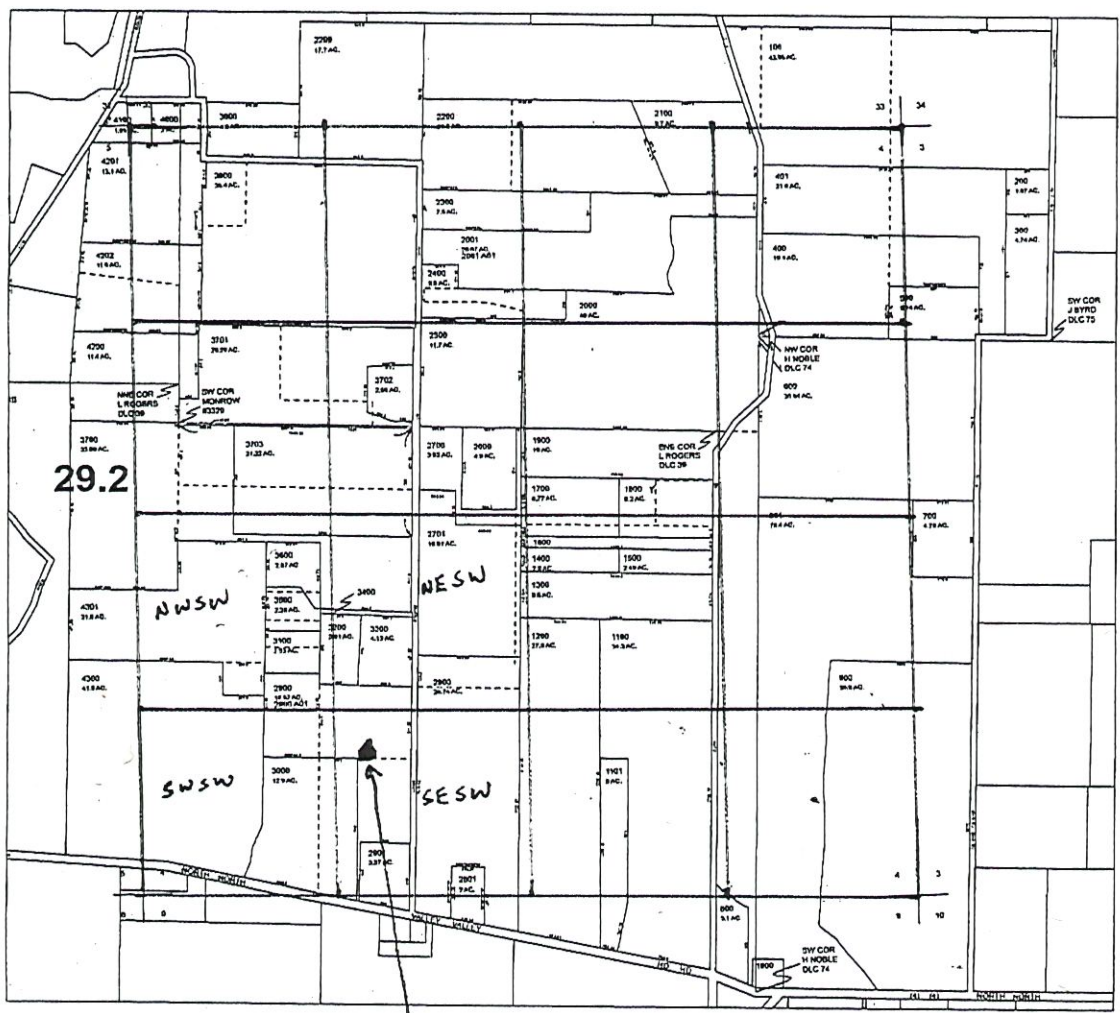

Reservoir



ASSESSMENT & TAX
CARTOGRAPHY
SECTION 4 T.3S. R.3W. W.M.
YAMHILL COUNTY OREGON

33 04

North

1" = 1320

CANCELLED TAXLOTS:
2481
1761
2481

DATE PRINTED: 5/11/2016

33 04

RECEIVED BY OWRD

MAR 02 2017

SALEM, OR

Location: 940' North and 1550' East from SW Corner
Section 4

Received
NOV 04 2024
OWRD

R-15235

R-88400