


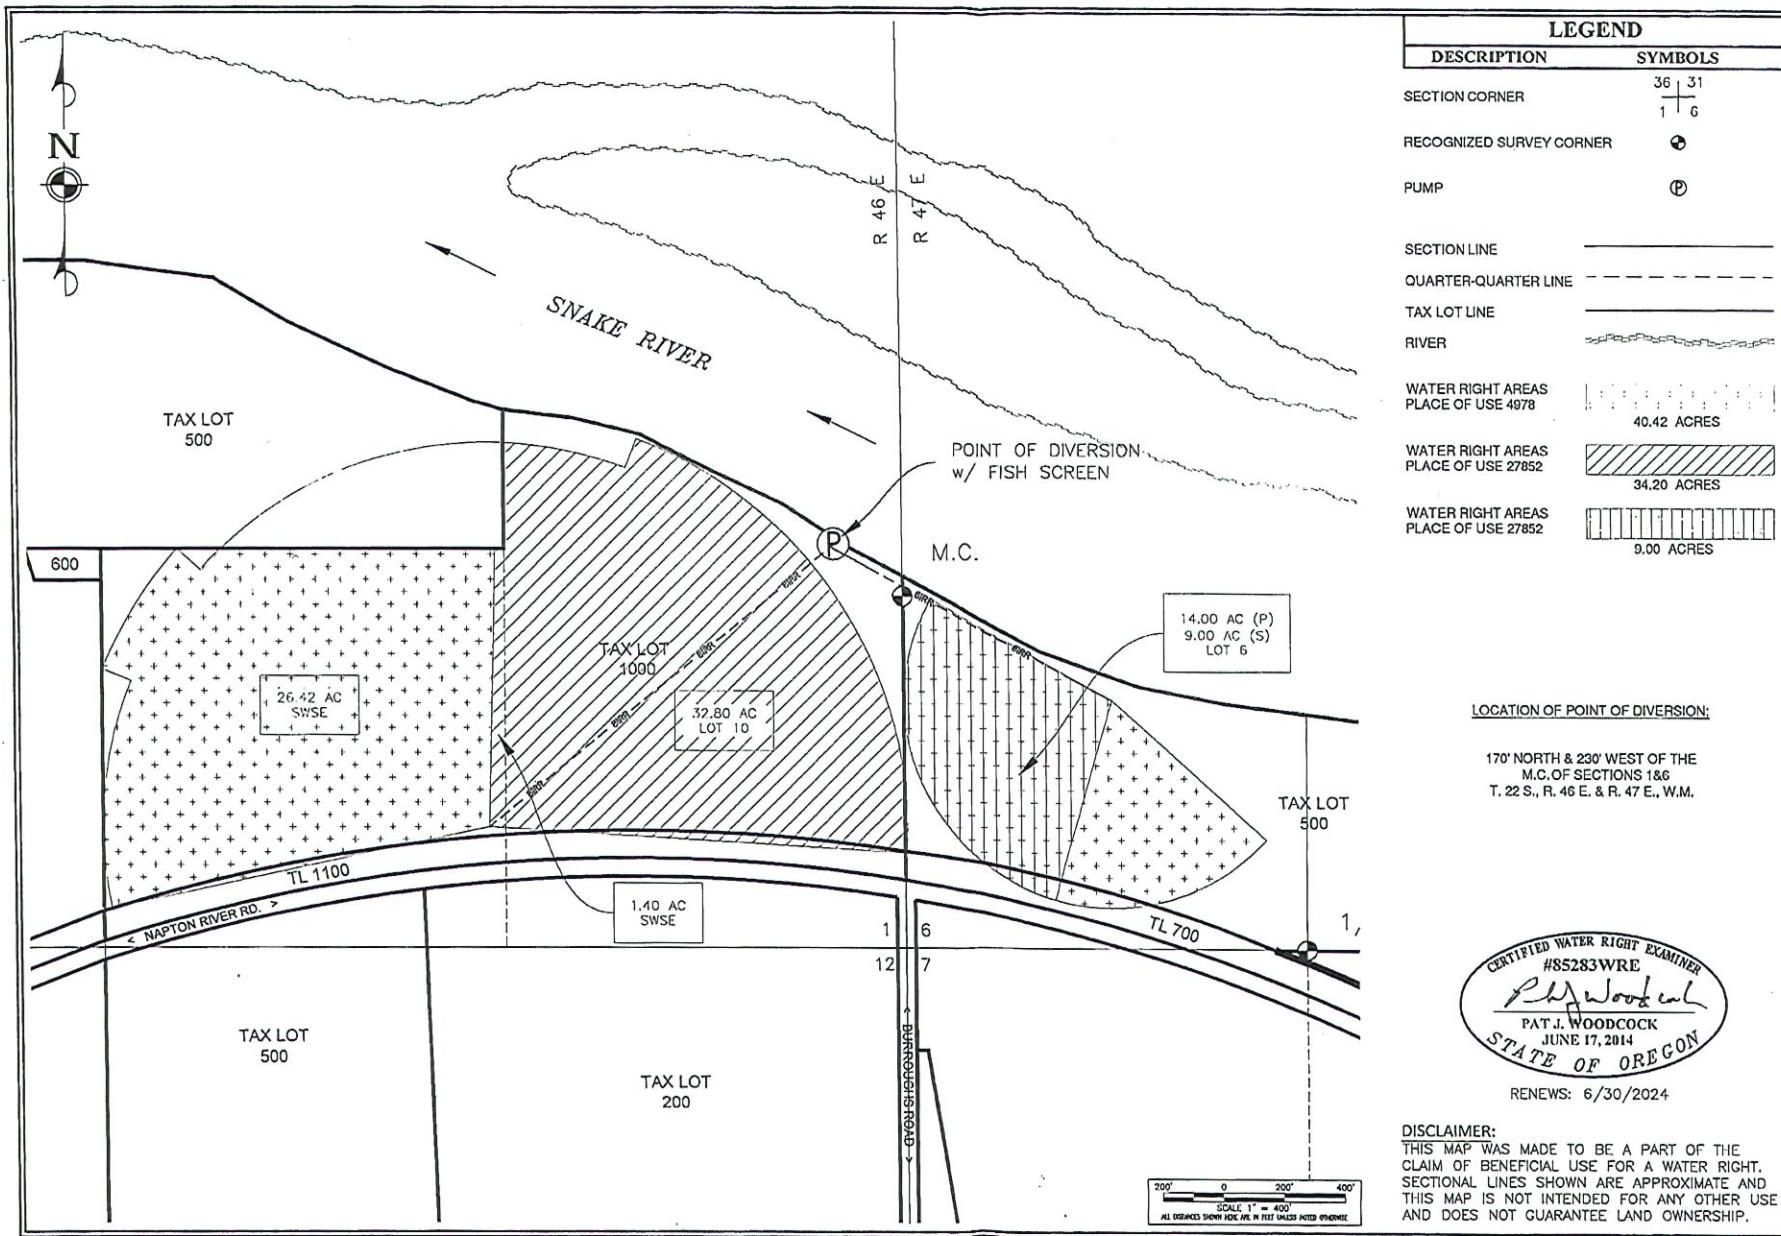

Reviewed By: PAT J. WOODCOCK
Drawn By: PJW
Print Date: NOVEMBER 1, 2022
DWG. Scale: AS SHOWN

CLAIM OF BENEFICIAL USE MAP
WATER RIGHT TRANSFER FOR
T-12366
T. 22S., R. 46E, Sec. 1 & T. 22S., R. 47E, Sec. 6, W.M.
CHANDELE BOWEN
1551 Highway 201
Adrian, Oregon 97901

ENGINEERING
NORTHWEST, LLC
11 NW 9th Street
Ontario, Oregon 97914
www.engr-nw.com (541)388-4432

W1
SHEET NO. 1 OF 1
JOB NO. 20-012