


CLAIM OF BENEFICIAL USE MAP

TO CHANGE PLACE OF USE AND
POINTS OF APPROPRIATION
FOR T-12375
DINSDALE FARMS, INC.

TOWNSHIP 27 SOUTH, RANGE 15 EAST, SECTION 23, W.M.
TAX LOT: 3500

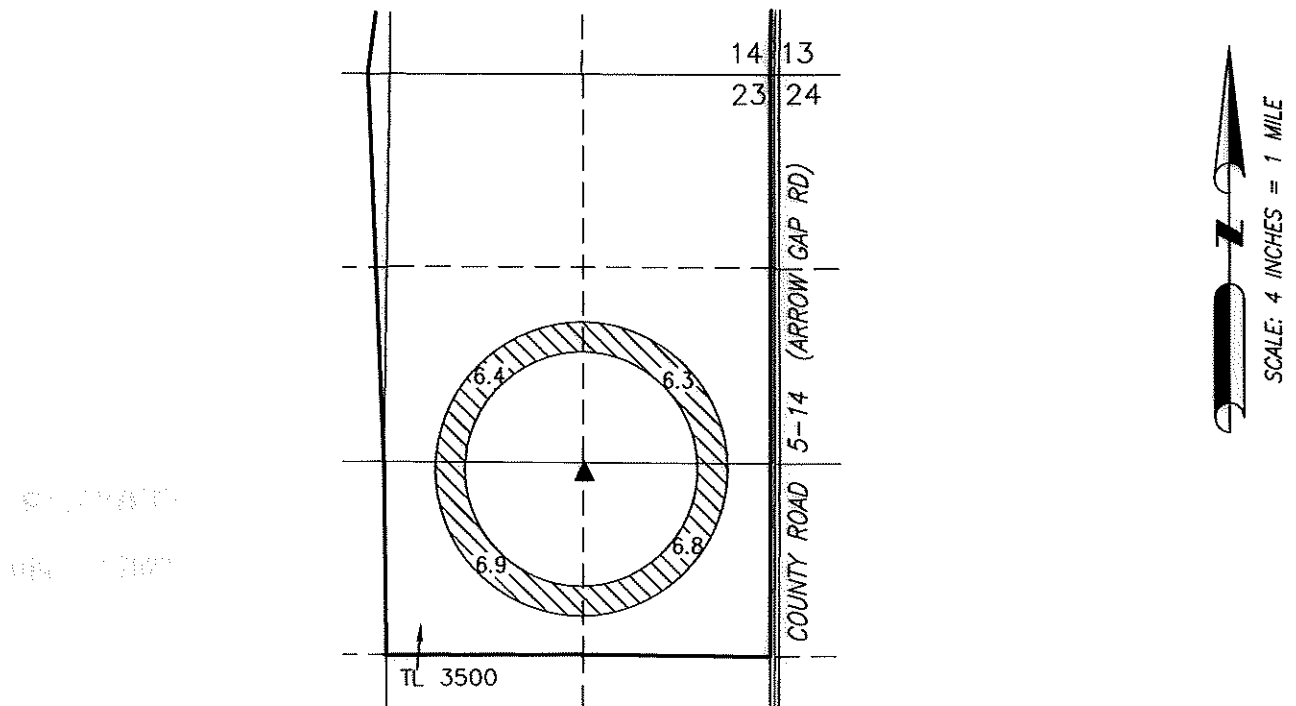


▲ #7 (LAKE 52380)

PROPOSED WELL IN THE NE 1/4 SE 1/4 SECTION 23,
T27S R15E, W.M. LOCATED 2726 FEET SOUTH AND 1316
FEET WEST FROM THE NE CORNER OF SECTION 23.

NEWLY INSTALLED METER IS APPROXIMATELY 5.0 FEET
WEST ALONG DELIVERY PIPE FROM WELL.



26.4 ACRES WATER RIGHTS FROM
CERTIFICATE #84171 (G-5925)
TRANSFERRED, AS SHOWN.

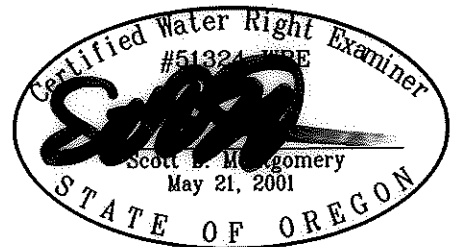

RENEWAL DATE: 12/31/2024

THIS MAP IS FOR THE PURPOSE OF LOCATING A WATER RIGHT ONLY AND HAS NO
INTENT TO PROVIDE LEGAL DIMENSIONS OR THE LOCATION OF PROPERTY LINES

PREPARED FOR:

SAM DINSDALE
57673 FORT ROCK ROAD
SILVER LAKE, OR 97638

PREPARED BY:



ALL POINTS ENGINEERING AND SURVEYING, INC.
P.O. BOX 767 TERREBONNE, OR 97760
(541) 548-5833 www.APEandS.com