

RECEIVED


OCT 16 1998

WATER RESOURCES DEPT.
SALEM, OREGON

T. 8S., R. 39E., W.M.



Scale 1" = 1320'

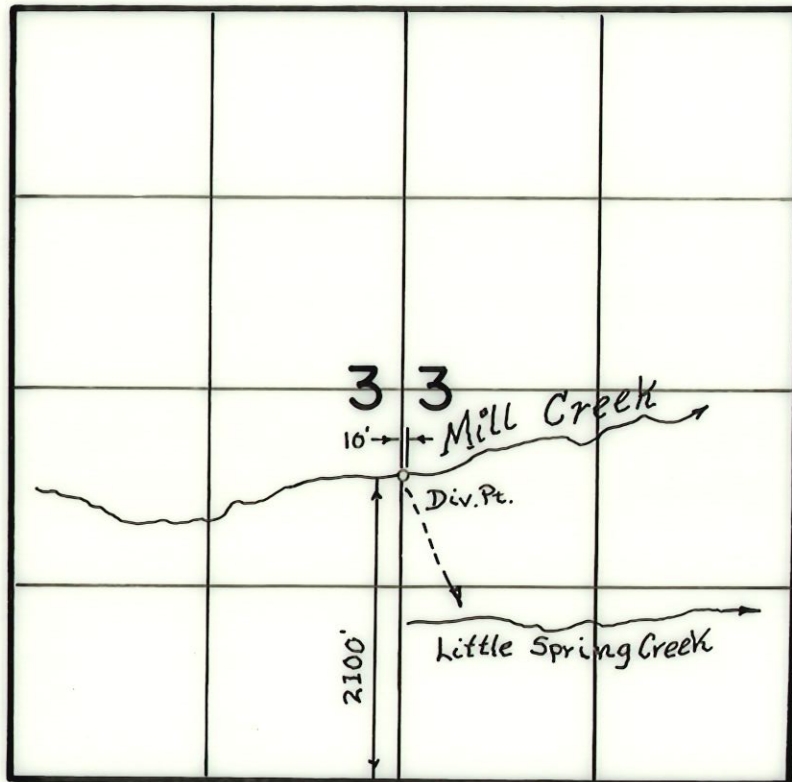

THE PURPOSE OF THIS MAP IS FOR IDENTIFYING THE LOCATION
OF THE WATER RIGHT ONLY AND IS NOT INTENDED TO PROVIDE
LEGAL DIMENSIONS OF PROPERTY OWNERSHIP LINES

FINAL PROOF SURVEY

UNDER

TRANSFER 6636

IN NAME OF

S.S.I. Land & Cattle Company

Surveyed Oct. 1, 1998

