


Claim of Beneficial Use
Permit S-54783, Application S-49201
A Water Right held by Pacific City Joint Water-Sanitary Authority
Tillamook County

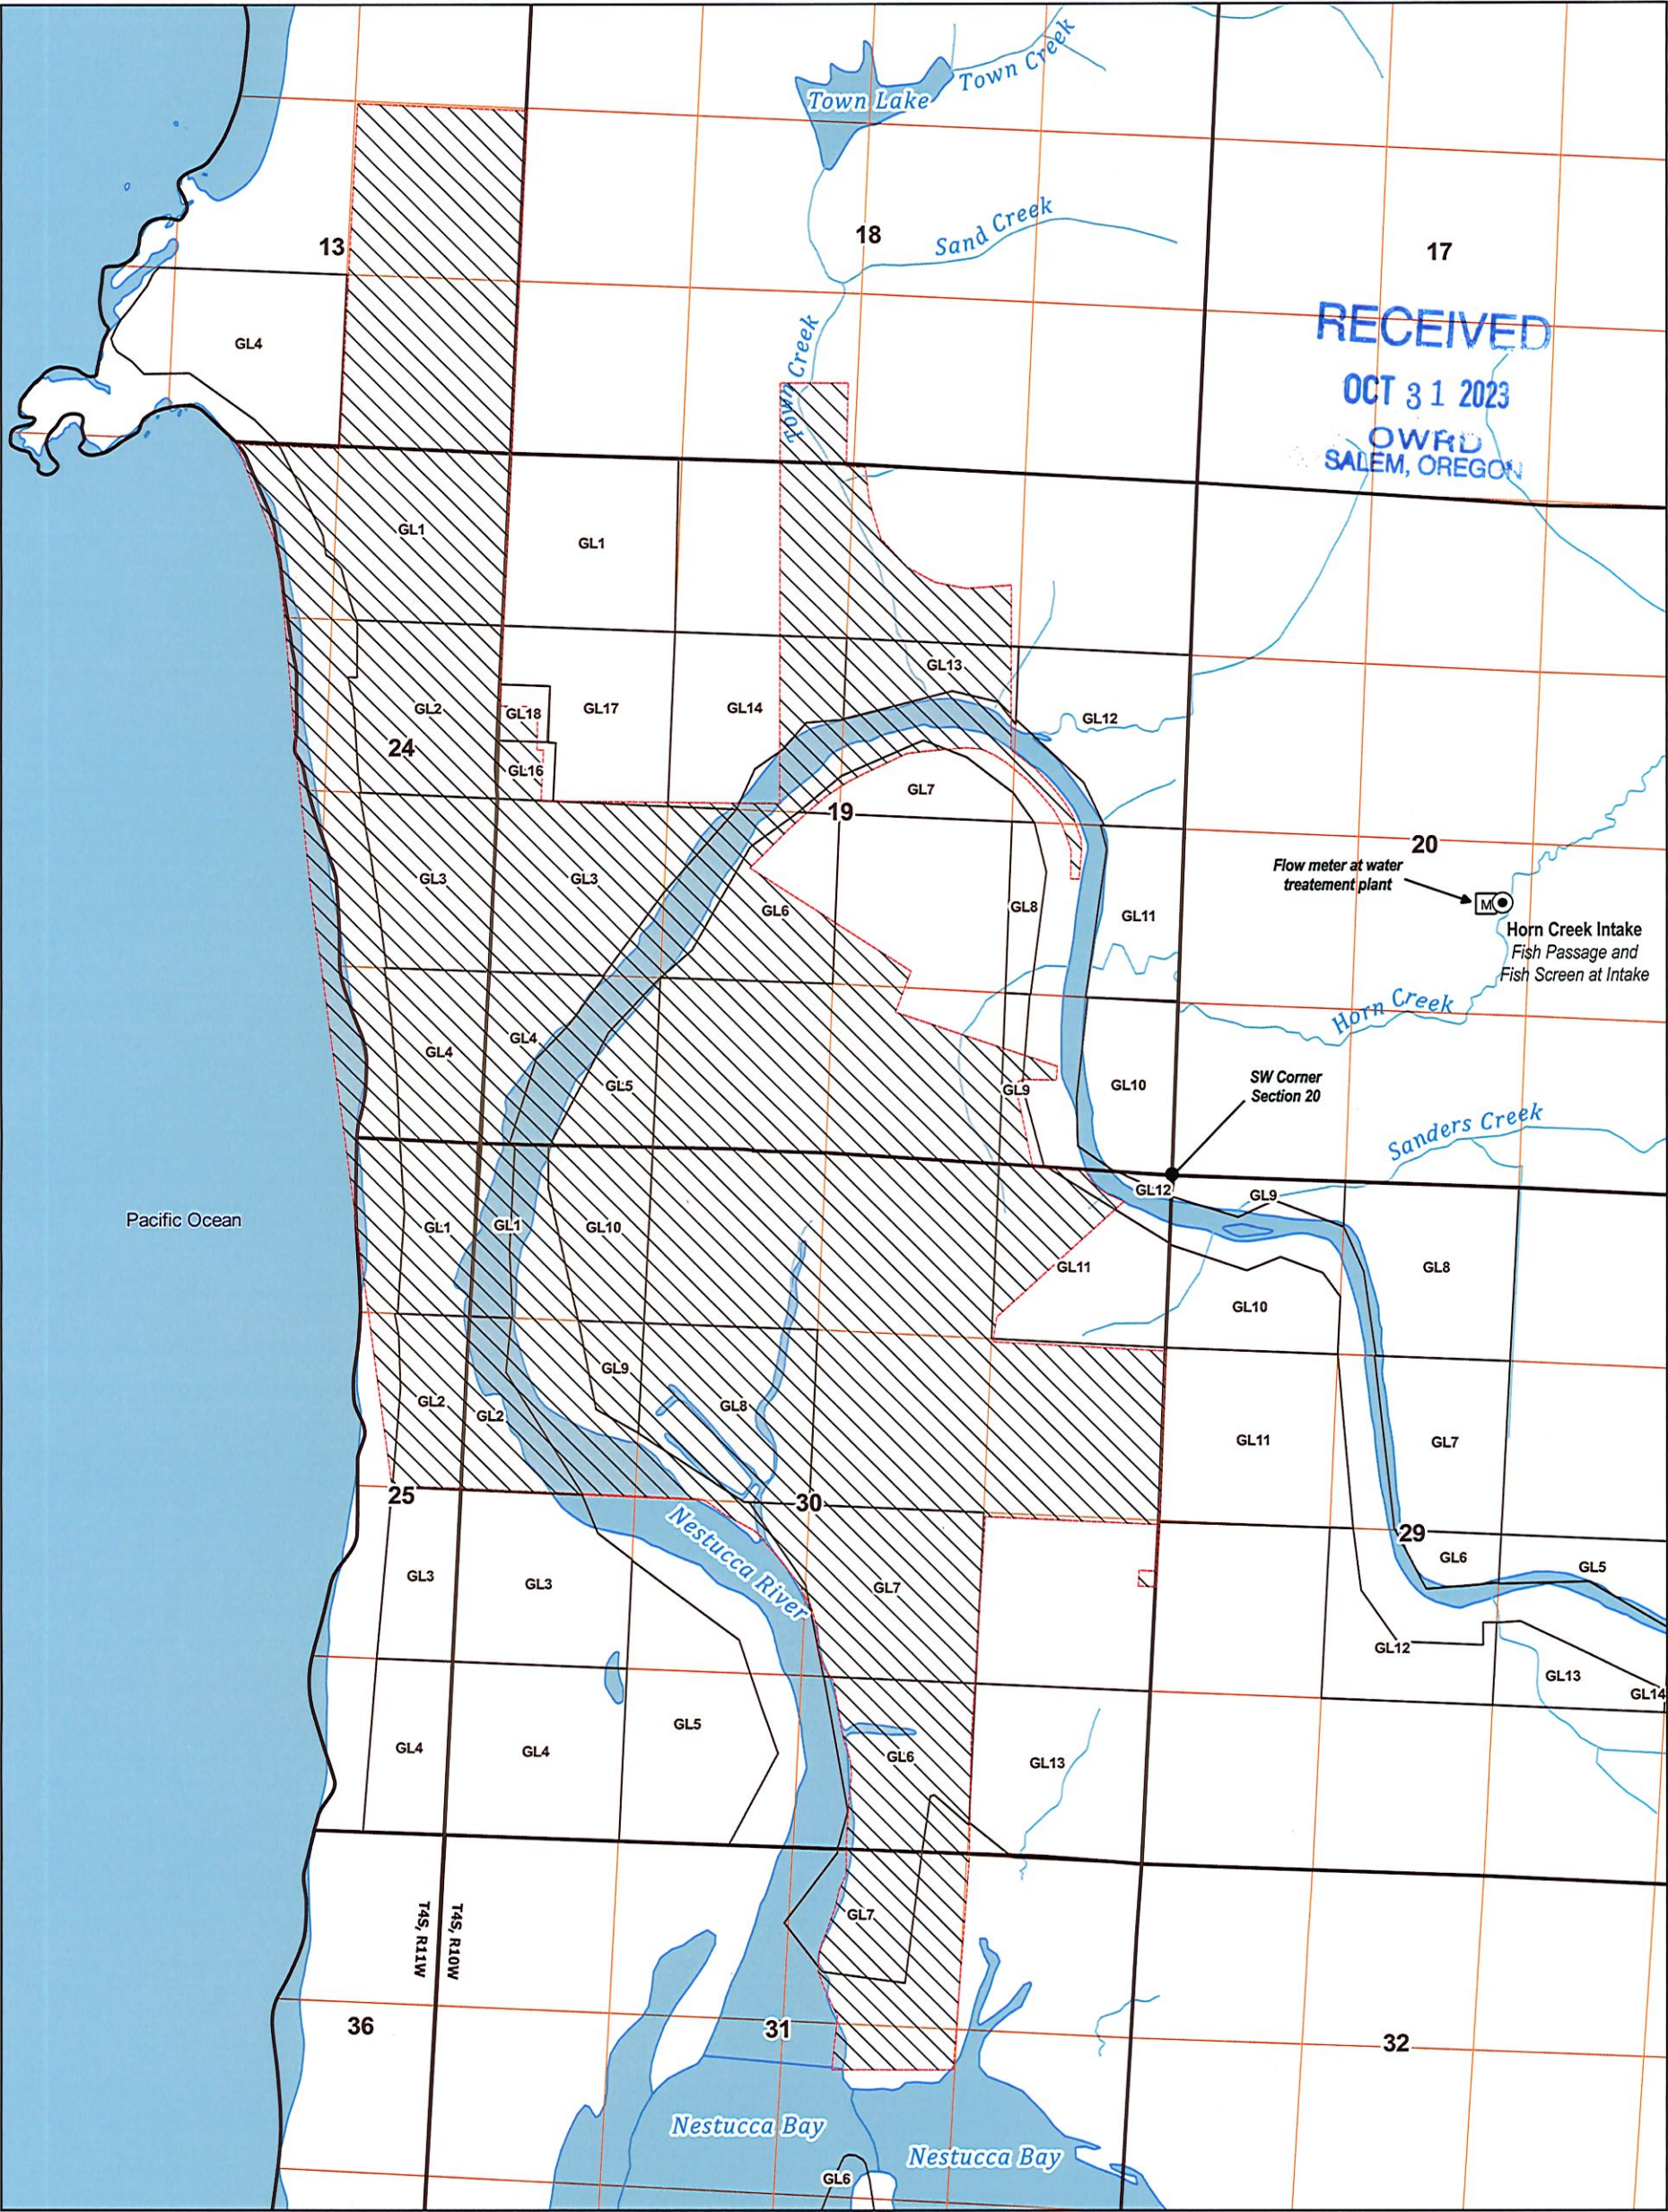

RECEIVED
OCT 31 2023
OWRD
SALEM, OREGON

Flow meter at water treatment plant
Horn Creek Intake
Fish Passage and
Fish Screen at Intake

SW Corner
Section 20

Pacific Ocean

Nestucca River

Nestucca Bay

Nestucca Bay

T4S, R10W
T4S, R11W

Legend

- POD - Horn Creek Intake
- Service Area Boundary (POU)
- Government Lots
- PLS Sections
- PLS QQ Sections
- Regional Waterbodies

POD Location Description

Horn Creek intake
Located 2,200 feet North and 2,450 feet East from the SW corner
of Section 20, Township 4 South, Range10 West (W.M)

Map Information

Date: 7/11/2023
Data Sources: BLM, OWRD, USGS, PCJWSA
Disclaimer: This map is not intended to provide legal dimensions
or property ownership lines.



Scale
0 660 1,320 ft
1-inch = 1320 feet

CERTIFIED WATER RIGHTS EXAMINER
#78185CWRE
THEODORE R. RESSLER
JUNE 29, 2007
STATE OF OREGON
RENEWS: 12-31-2024

