
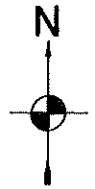


MAP FOR

Claim of Beneficial Use

NE 1/4, S5, T2N, R3W, WASHINGTON COUNTY

Application R-88456, Permit R-15430

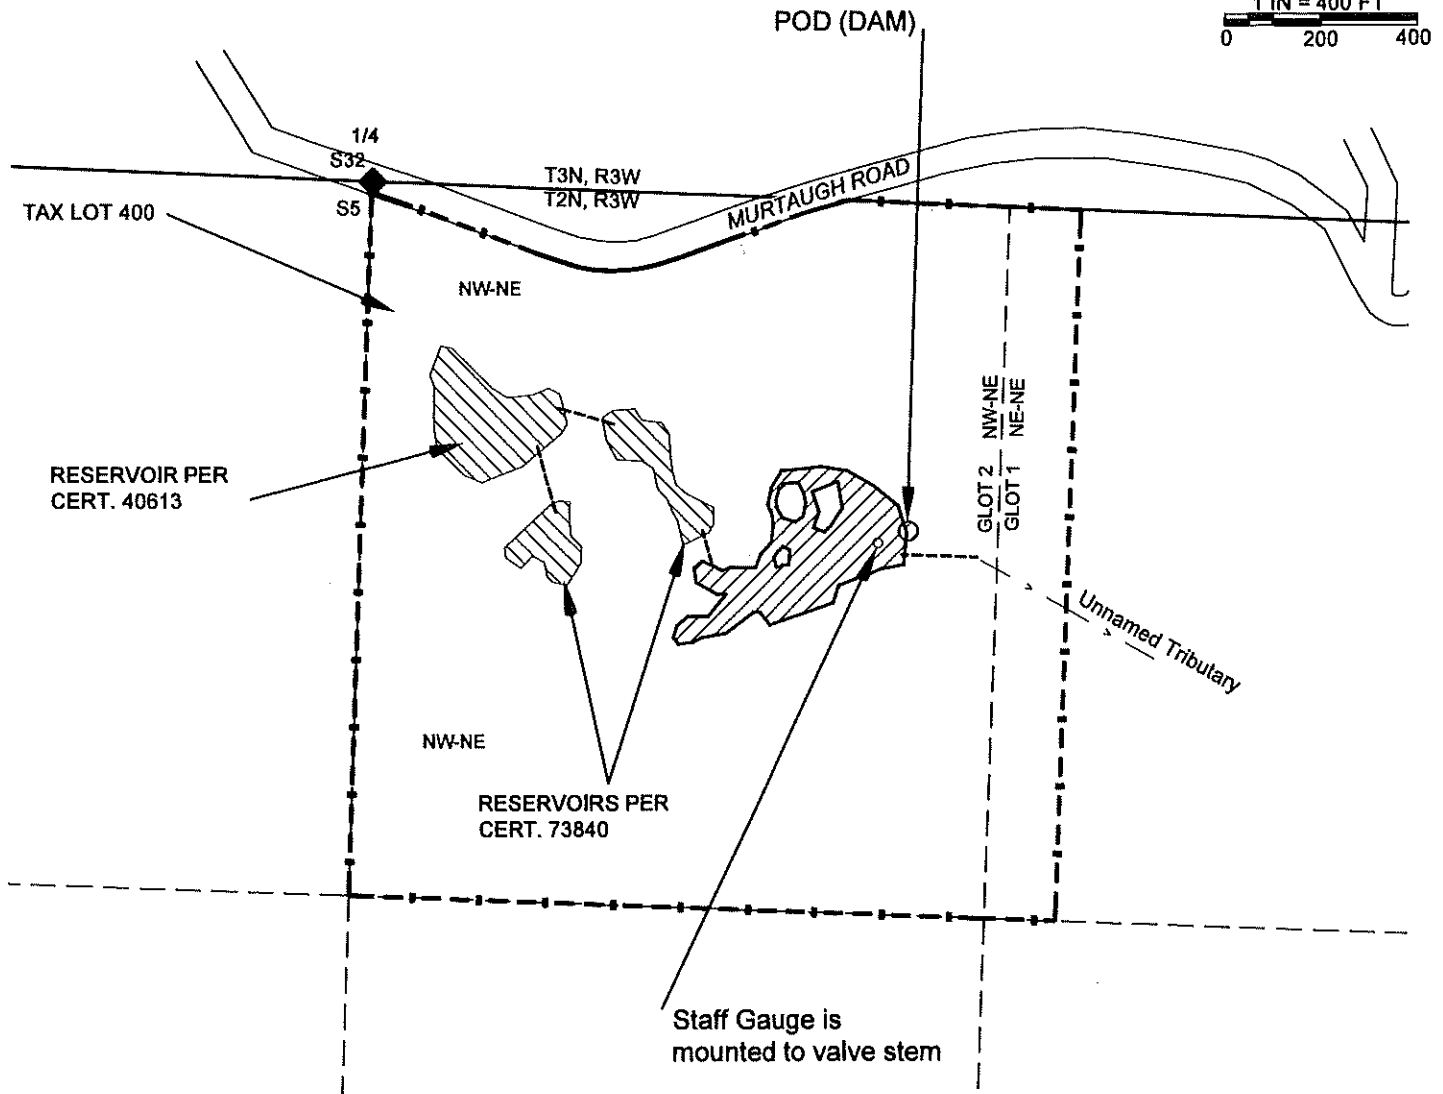

1 IN = 400 FT
0 200 400


THE POINT OF DIVERSION IS A DAM WHICH IS: 730 FEET SOUTH AND 1120 EAST FROM THE NORTH 1/4 OF SECTION 5.

NOTES:

- THIS MAP IS NOT INTENDED TO PROVIDE LEGAL DIMENSIONS OR LOCATIONS OF PROPERTY OWNERSHIP LINES.
- PROPERTY LINES AND QUARTER-QUARTER LINES ARE BASED ON THE TAX ASSESSOR MAP FOR SECTION 5, T2S, R3W.
- THE RESERVOIR OUTLINES ARE BASED ON AERIAL PHOTO INTERPRETATION.
- NO DONATION LAND CLAIMS EXIST ON OR NEAR THE TAX LOT.

LEGEND

- ◆ NORTH 1/4 CORNER SECTION 5
- POINT OF DIVERSION
- > STREAM OR SURFACE DRAINAGE
- TAX LOT LINE
- SECTION LINE
- QUARTER-QUARTER LINE
- ▨ OTHER RESERVOIR
- ▨ SUBJECT RESERVOIR
- GLOT # GOVERNMENT LOT AND NUMBER
- OUTLET PIPE

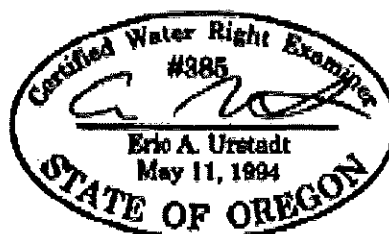

Expires: 30 JUN 2024

Received
JUN 07 2024

OWRD

MAP BY:
**ASPEN RURAL LAND
CONSULTING**
ERIC URSTADT, PE, PLS
9MAY 2024
MurtaughRes2A