


TOWNSHIP 16 SOUTH, RANGE 22 EAST, W.M.
CROOK COUNTY

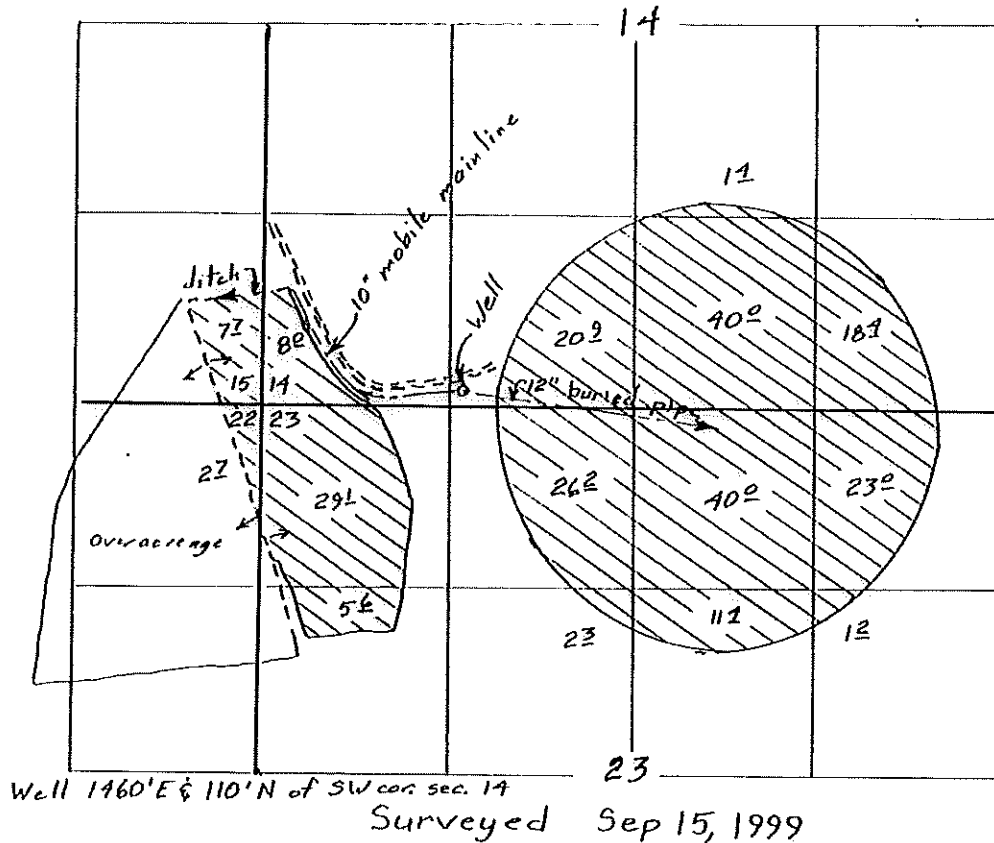


Scale 1" = 1320'

Claim of Beneficial Use Map
for
GUTIERREZ CATTLE Co.

App G-13520

Per G-12657

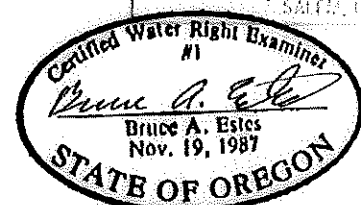

This map is for the purpose of
locating a water right only
and has no intent to provide
legal dimensions or the location
of property lines.

ESTES SURVEYS

PO Box 17519
Salem, OR 97305-7519
(503) 585-7593

60382 Arnold Rd
Bend, OR 97702
(541) 382-7391