


T.7S. R.1W. Section 6 T.7S. R.2W. Section 1, W.M.

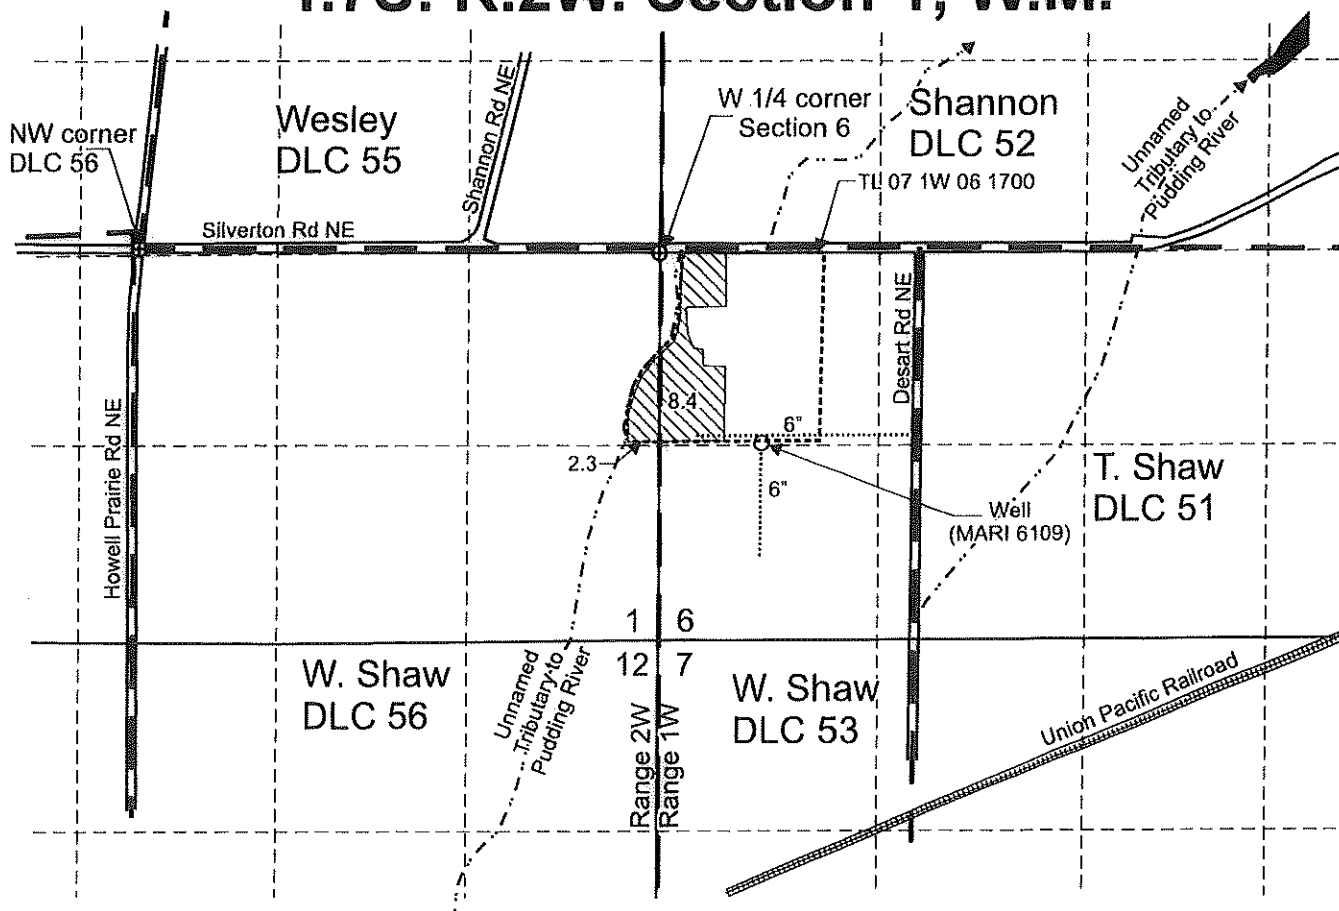

Well (MARI 6109) is located 1,320 feet south and 700 feet east from the W 1/4 corner, Section 6.

 Area (10.7 Acres) irrigated under T-13449 formerly Certificate 52663, priority date May 23, 1979.


----- Tax lot boundary

— . — Donation Land Claim boundary


..... Water main line



Scale: 1" = 1,320'

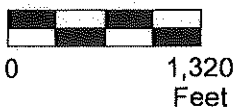

This map was prepared for the purpose of identifying the location of a water right only and is not intended to provide legal dimensions or location of property ownership lines.

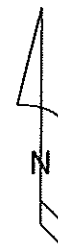

Pacific Hydro-Geology Inc.

09/2023

Claim of Beneficial Use Map
T-13449 formerly Certificate 52663

MDD Holding LLC c/o David King
T.7S. R.1W. Section 6,
T.7S. R.2W. Section 1, W.M.