


Received
DEC 24 2024
OWRD

CERTIFIED WATER RIGHT EXAMINER
78185
Theodore R. Ressler
THEODORE R RESSLER
JUNE 29, 2007
STATE OF OREGON
RENEWS: 12.31.2026
CWRE Seal and Signature

T.12 S. R.5 W. W.M.

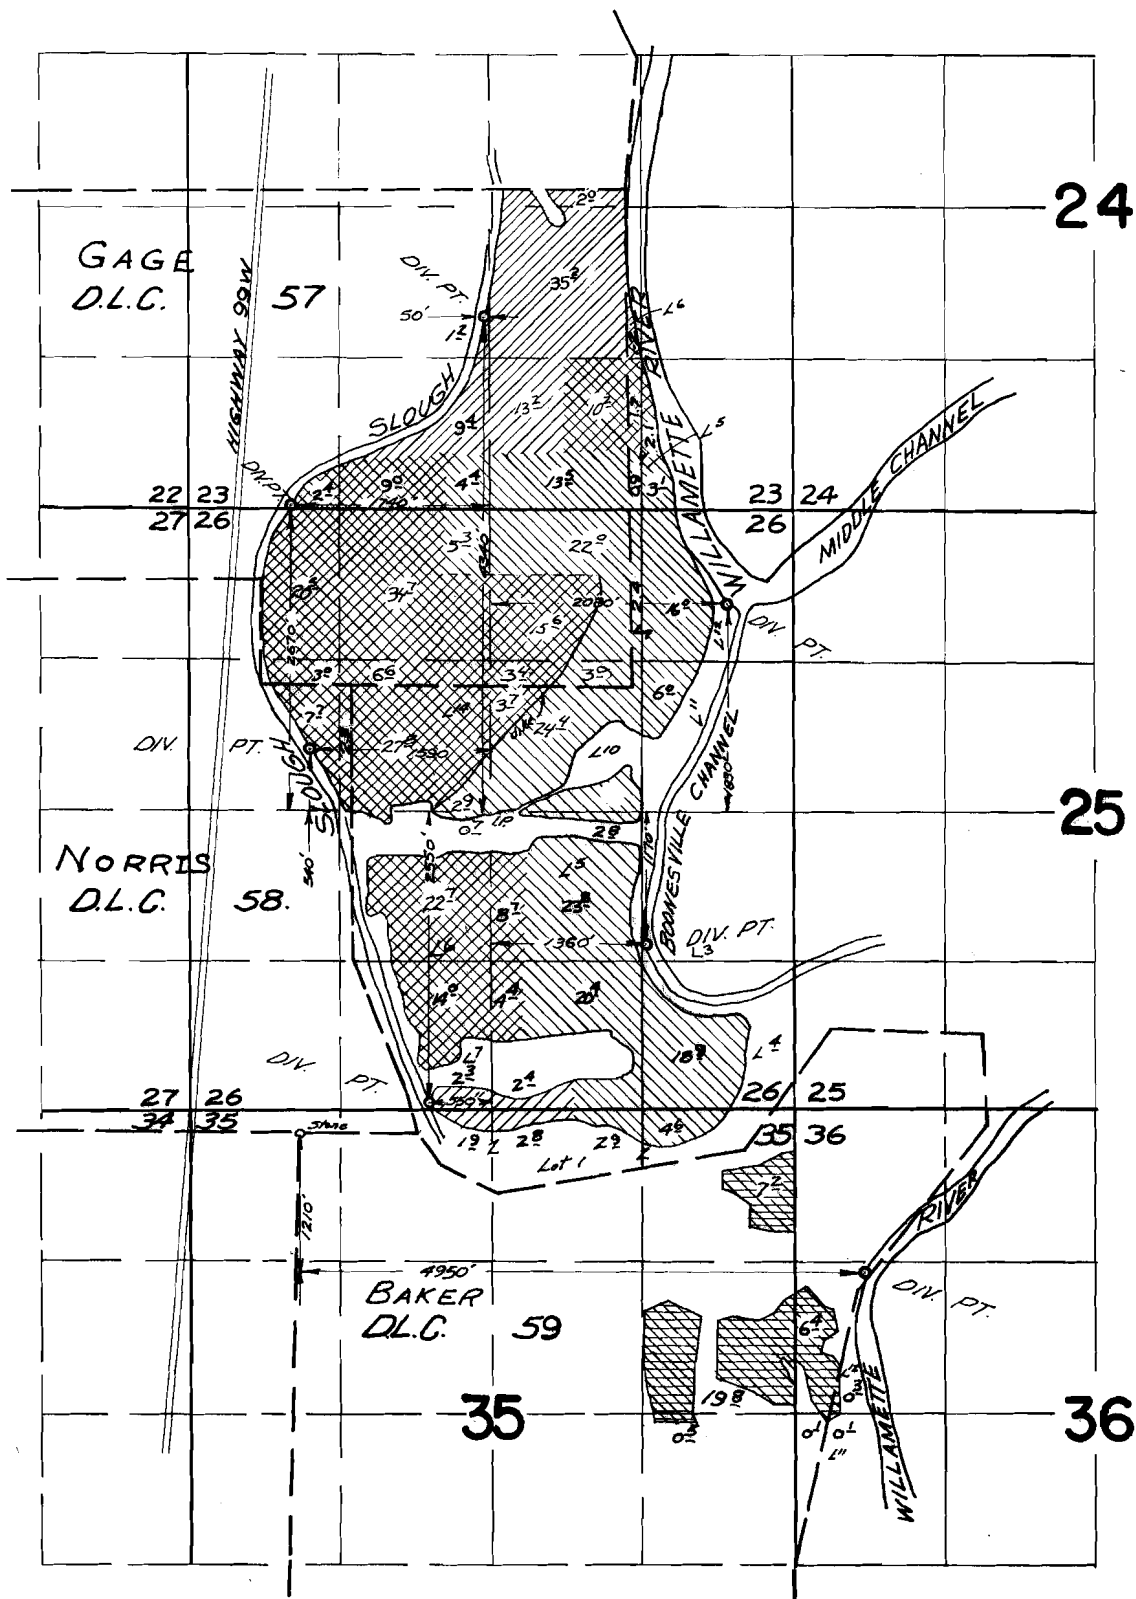

FINAL PROOF SURVEY UNDER

Application No. 34839 Permit No. 27350

IN NAME OF
C. E. JONES

Surveyed April 27, 1966 by V. Garner

DFJ-SP-52
1966-A

WILLAMETTE

SLOUGH

Willamette supplemental to slough

Willamette supplemental to well