


T 39 S, R 18 E

AN

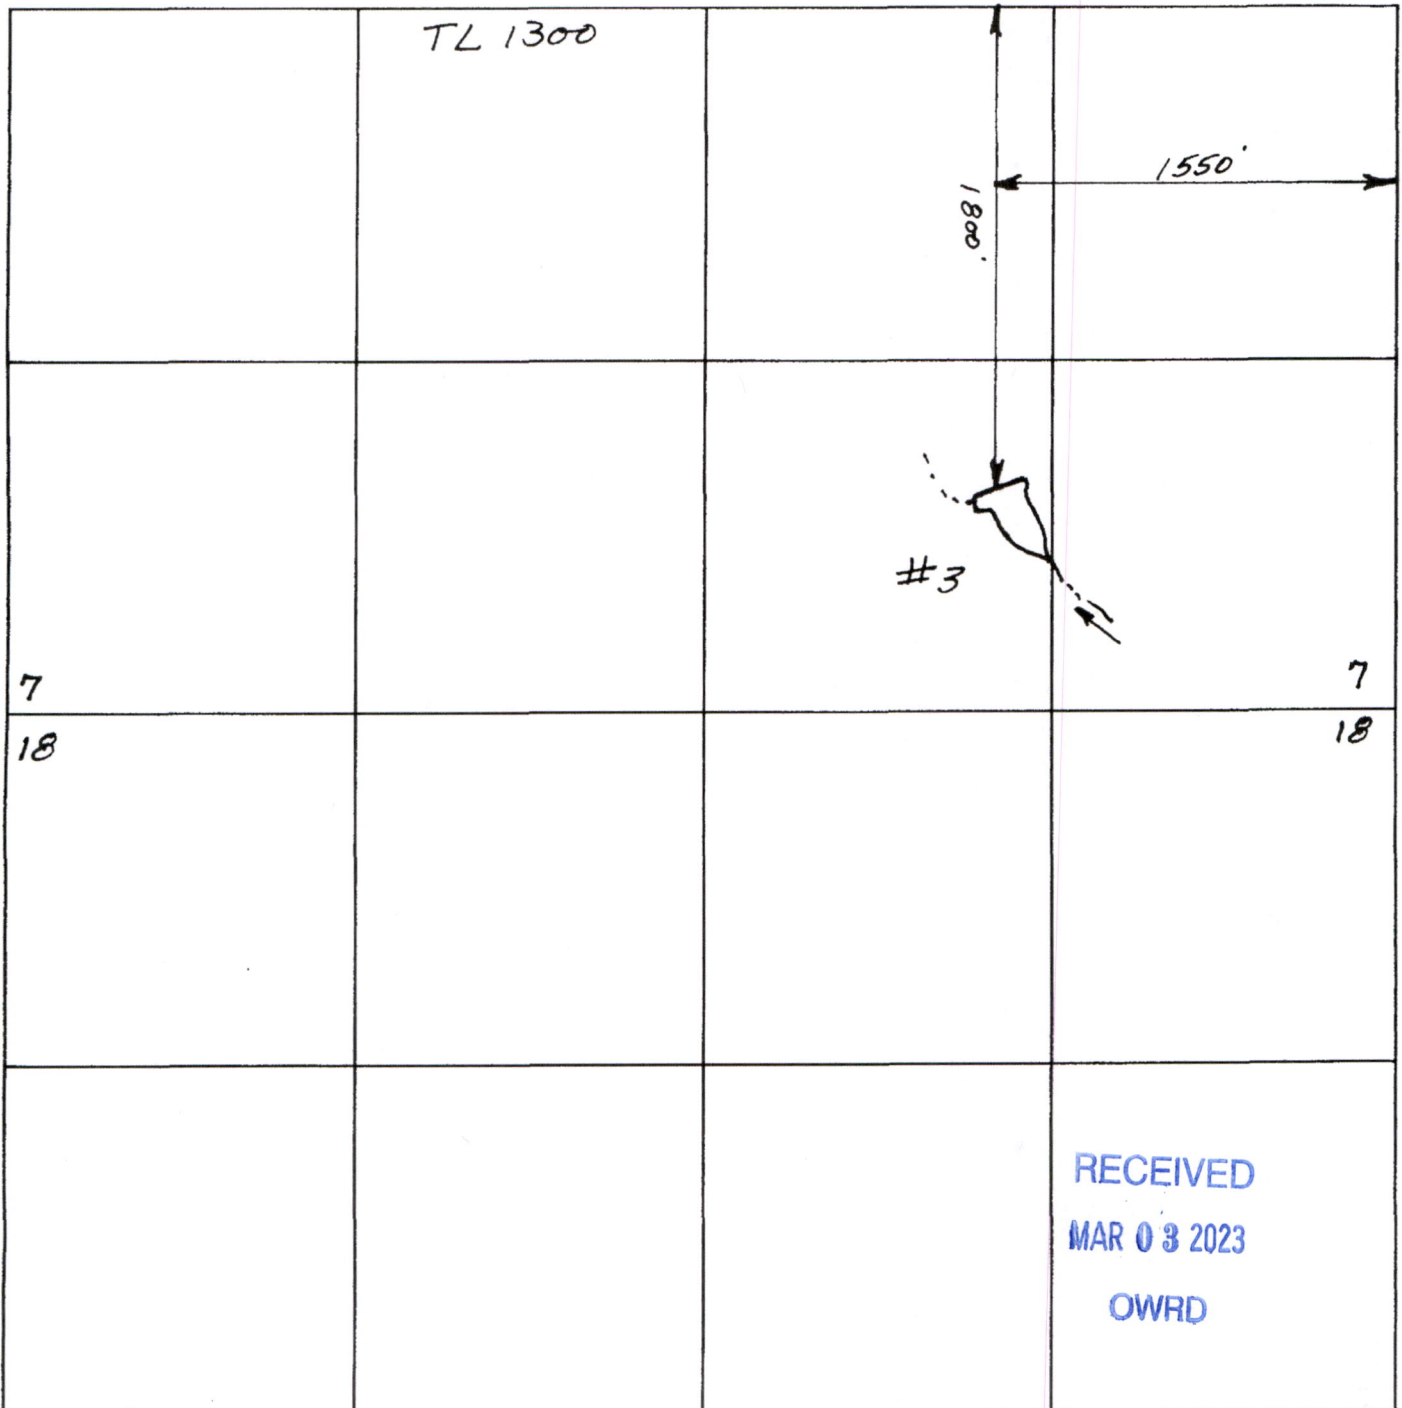

Scale 8" = 1 mile

app no R-85763
Permit No R-13902

RECEIVED

AUG 27 2003

WATER RESOURCES DEPT.
SALEM, OREGON