


T 39 S, R 18 E

AKH

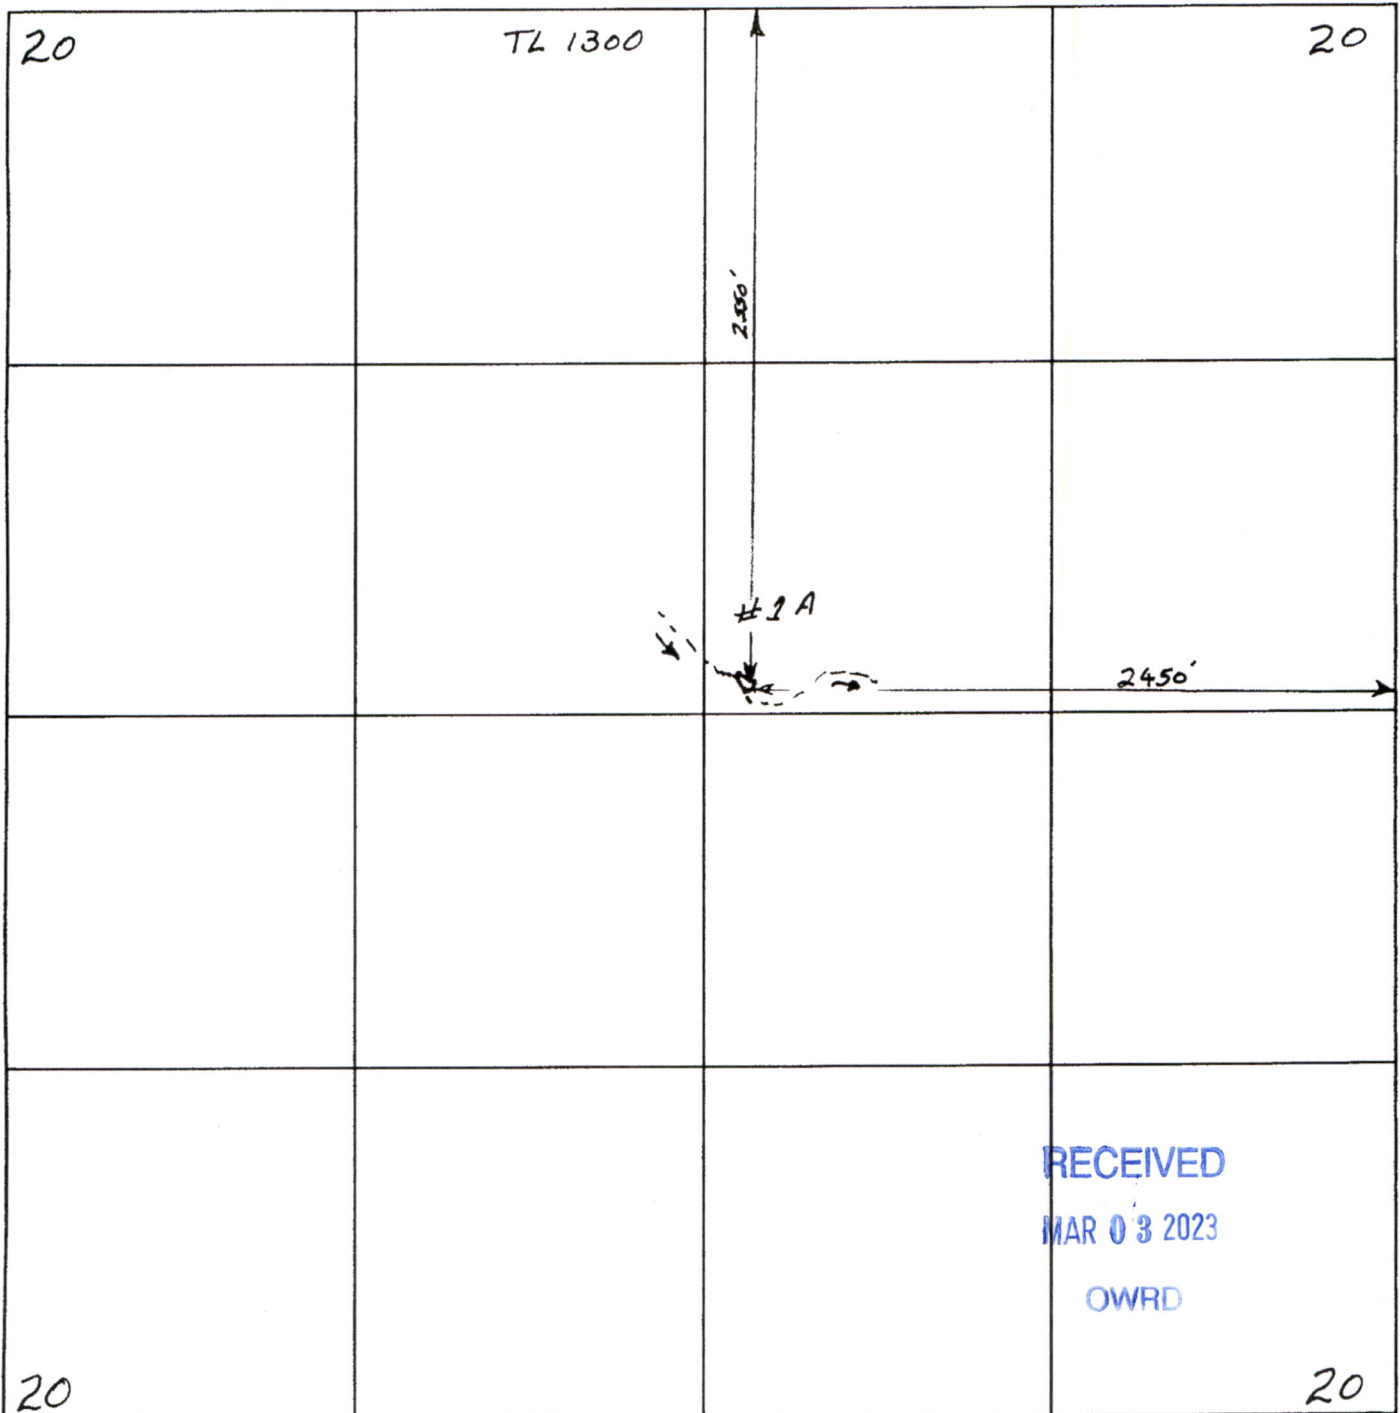

Scale 8" = 1 mile

RECEIVED

AUG 27 2003

WATER RESOURCES DEPT.
SALEM, OREGON

app no R-85764
Permit No R-13903