


T 39 S, R 17 E

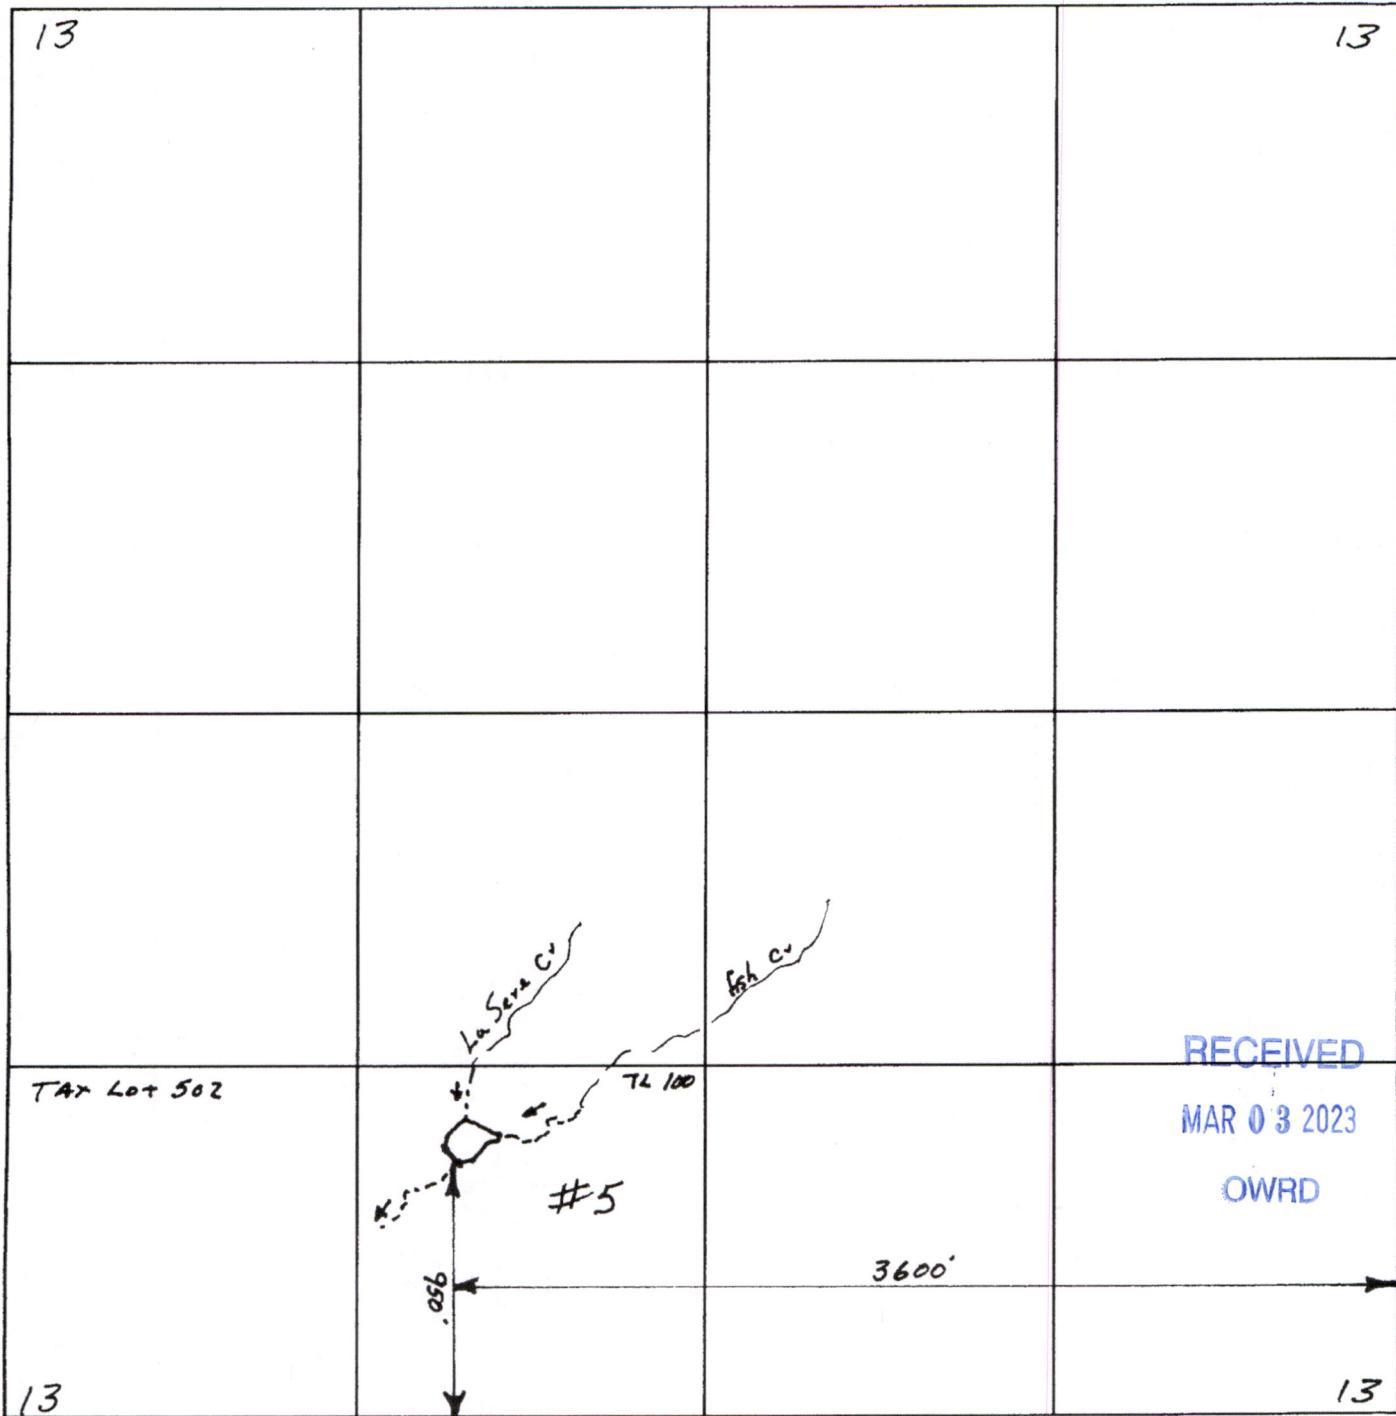

Scale 8" = 1 mile

app no 12-85765
Permit No 12 13904

RECEIVED
AUG 27 2003

WATER RESOURCES DEPT.
SALEM, OREGON