


T 39 S, R 18 E

A
K
E

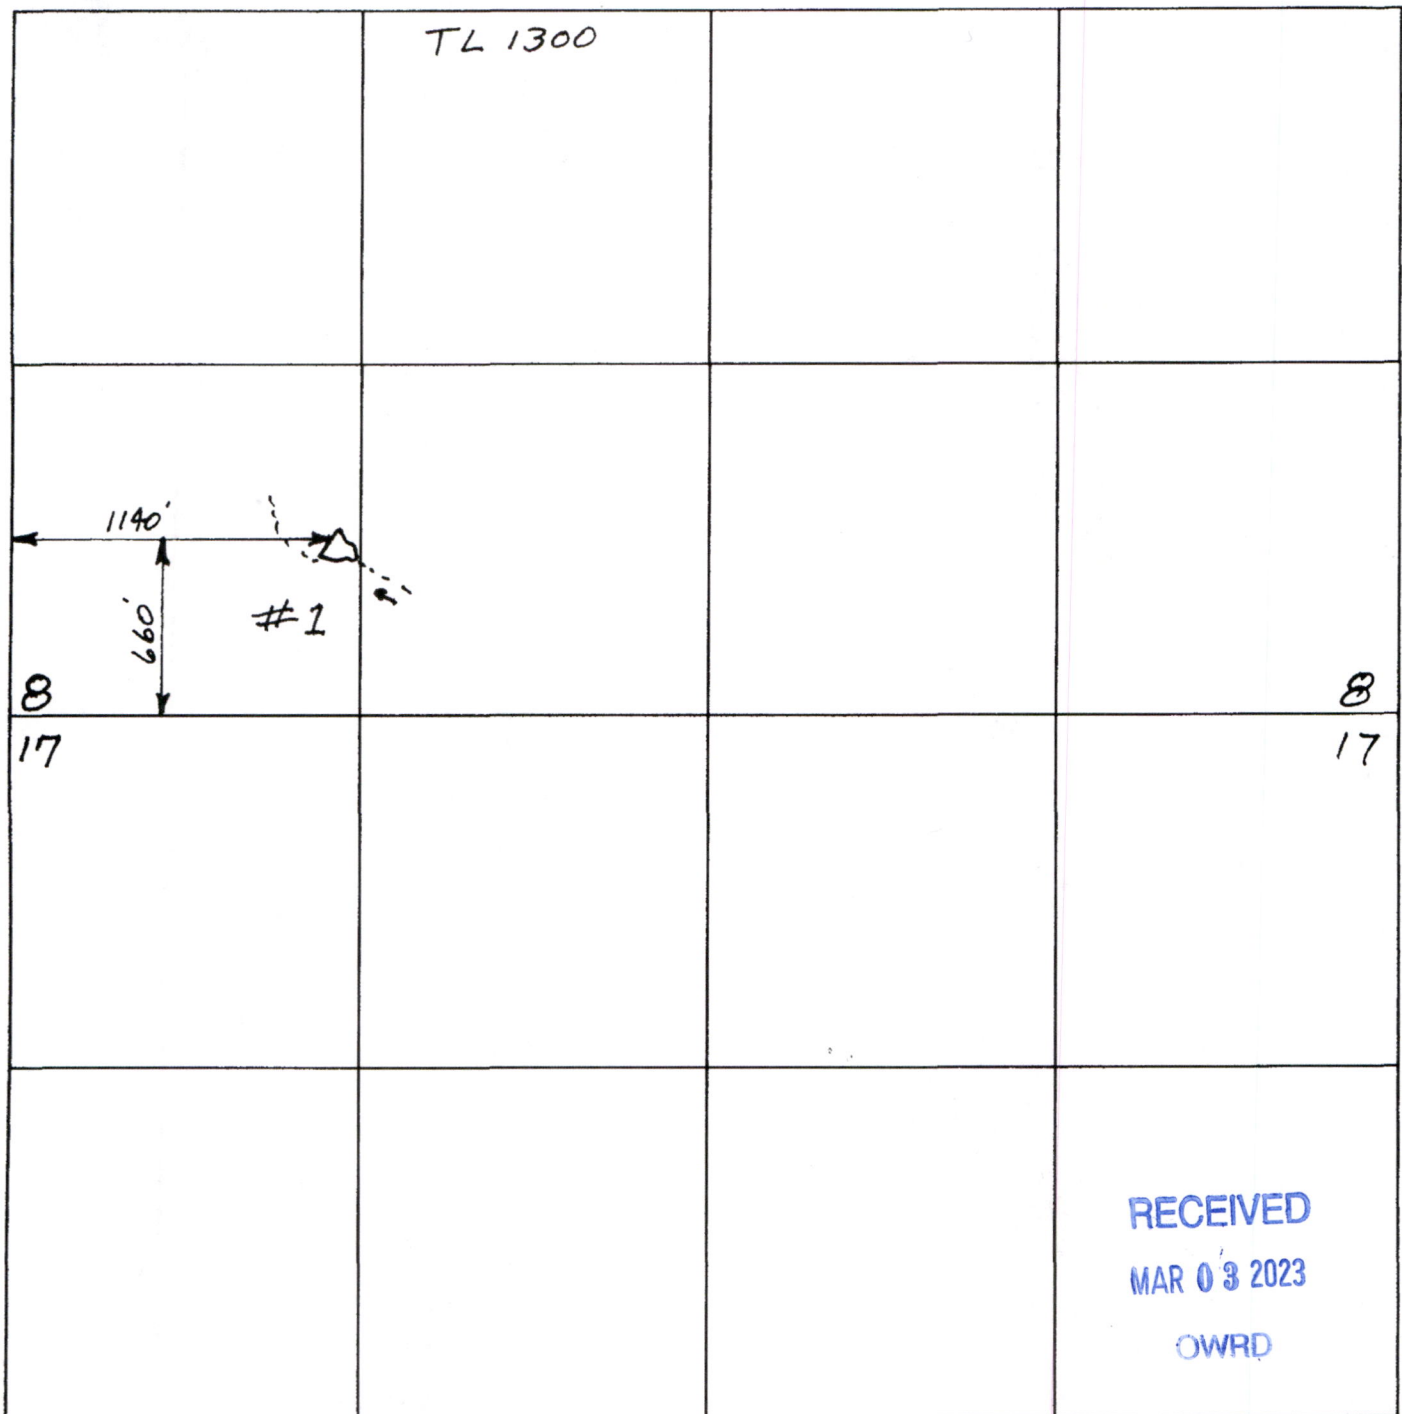

Scale 8" = 1 mile

approved R-05766
Permit No R-13905

RECEIVED
AUG 27 2003
WATER RESOURCES DEPT
SALEM, OREGON