


# T 39 S, R 18 E

42

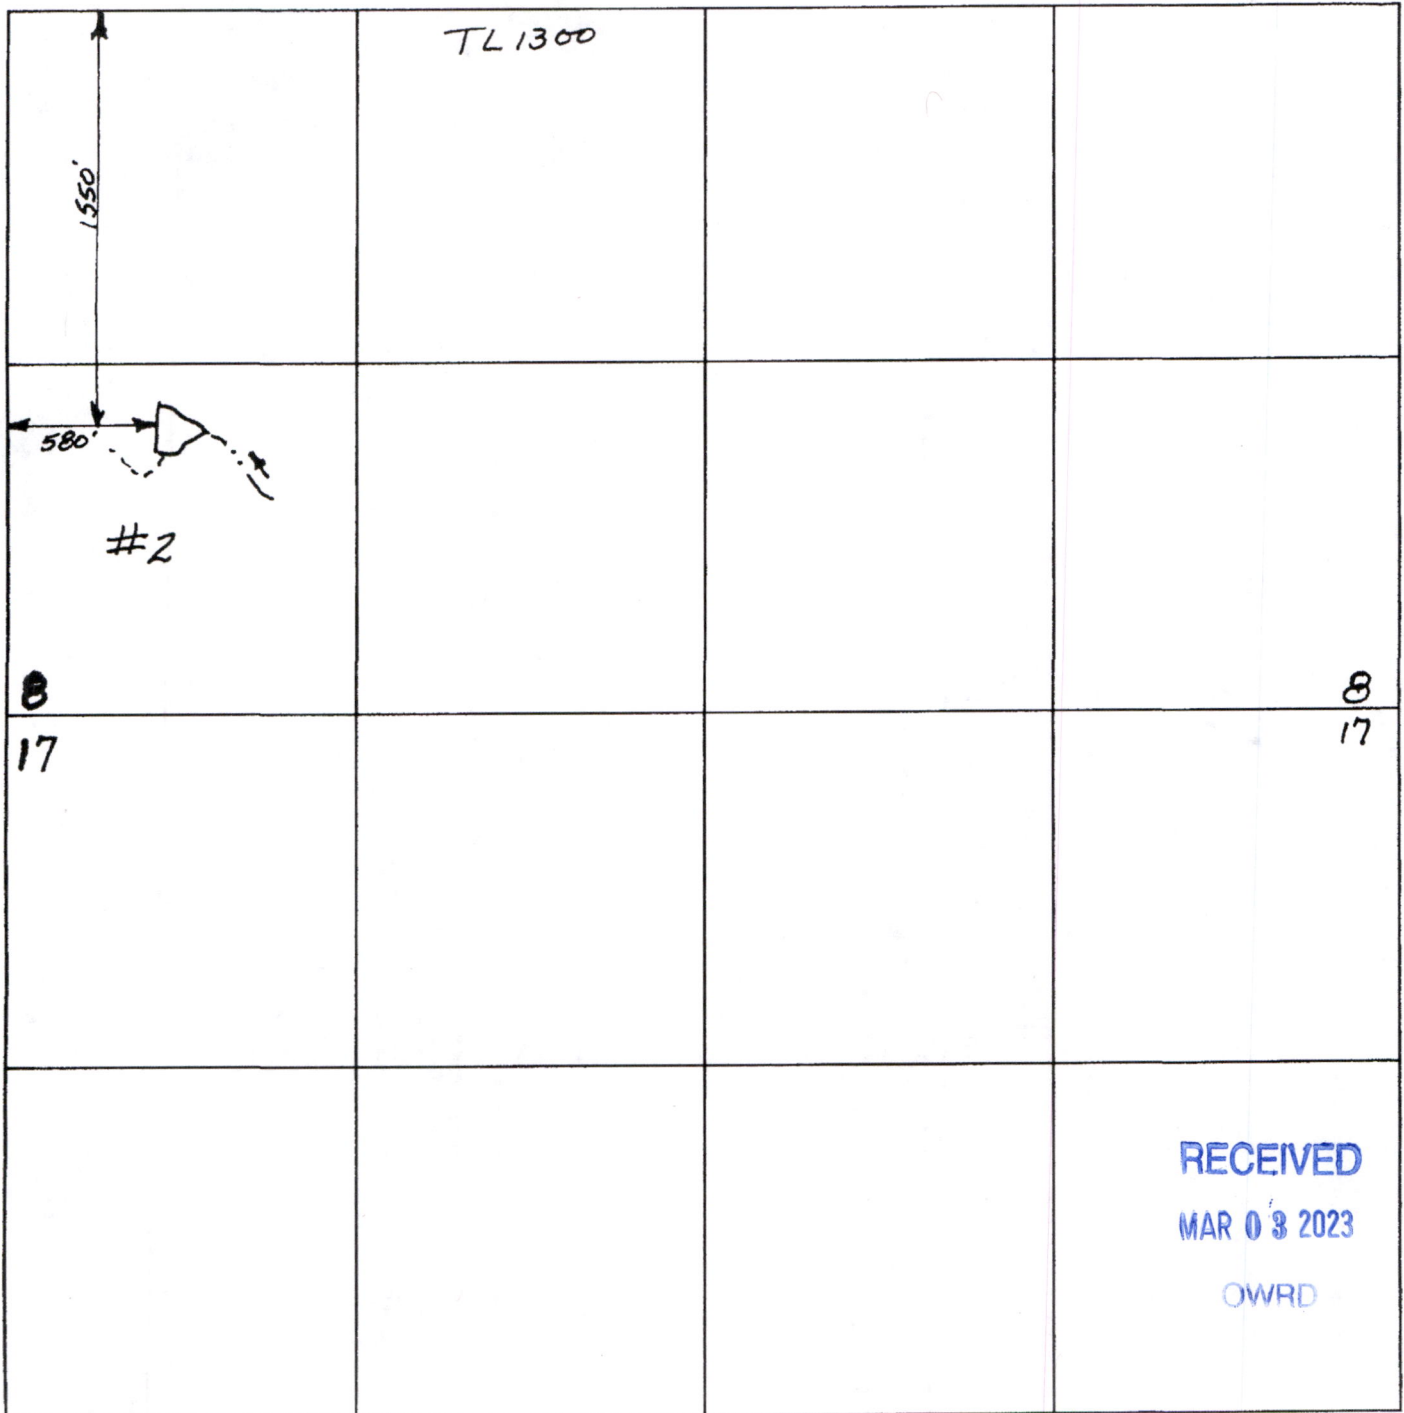

Scale 8" = 1 mile

app no R-85767  
Permit No R-13906

**RECEIVED**

AUG 27 2003

WATER RESOURCES DEPT.  
SALEM, OREGON