


T.4S. R.2W. Sec. 5, 6, 7 & 8, W.M.

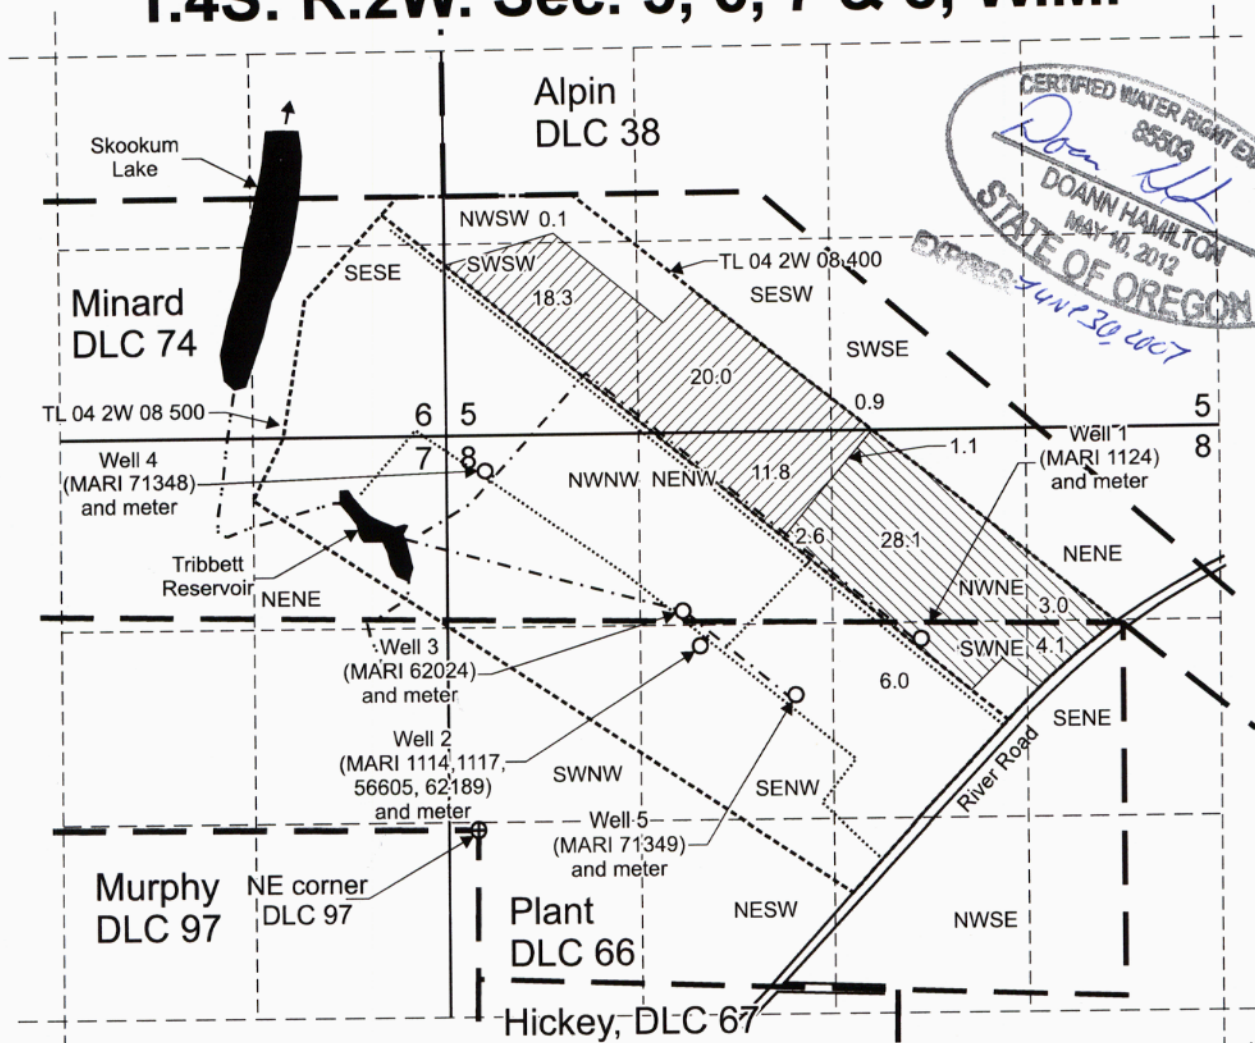

Well 1 (MARI 1124) is located 1,260 feet north and 3,040 feet east from the NE corner, DLC 97.
 Well 2 (MARI 1114, 1117, 56605, 62189) is located 1,230 feet north and 1,530 feet east from the NE corner, DLC 97.
 Well 3 (MARI 62024) is located 1,470 feet north and 1,410 feet east from the NE corner, DLC 97.
 Well 4 (MARI 71348) is located 2,440 feet north and 60 feet east from the NE corner, DLC 97.
 Well 5 (MARI 71349) is located 890 feet north and 2,180 feet east from the NE corner, DLC 97.

Area (43.8 acres) of primary irrigation under T-10618, formerly Certificate 40576, priority date: 3-22-1966, irrigated by wells 1, 3, 4, and 5

Area (52.2 acres) of primary irrigation under T-10618, formerly Certificate 40576, priority date: 3-22-1966, irrigated by wells 2, 3, 4, and 5.

----- Tax lot boundary ——— Donation Land Claim boundary

- - - - 6 inch Water main line, to the pond 6 inch Water main line, to the place of use

Scale: 1" = 1,320'



This map was prepared for the purpose of identifying the location of a water right only and is not intended to provide legal dimensions or location of property ownership lines.

Claim of Beneficial Use Map
T-10618, formerly Certificate 40576

Pacific Hydro-Geology Inc.

11/2024
 Rev. 06/2025

Kelly Farms, Inc.
 T.4S, R. 2W. Sec. 5. 6. 7 & 8 , W.M.

Received
 JUN 09 2025
 OWRD