


T.4S. R.2W. Sec. 5, 6, 7 & 8, W.M.

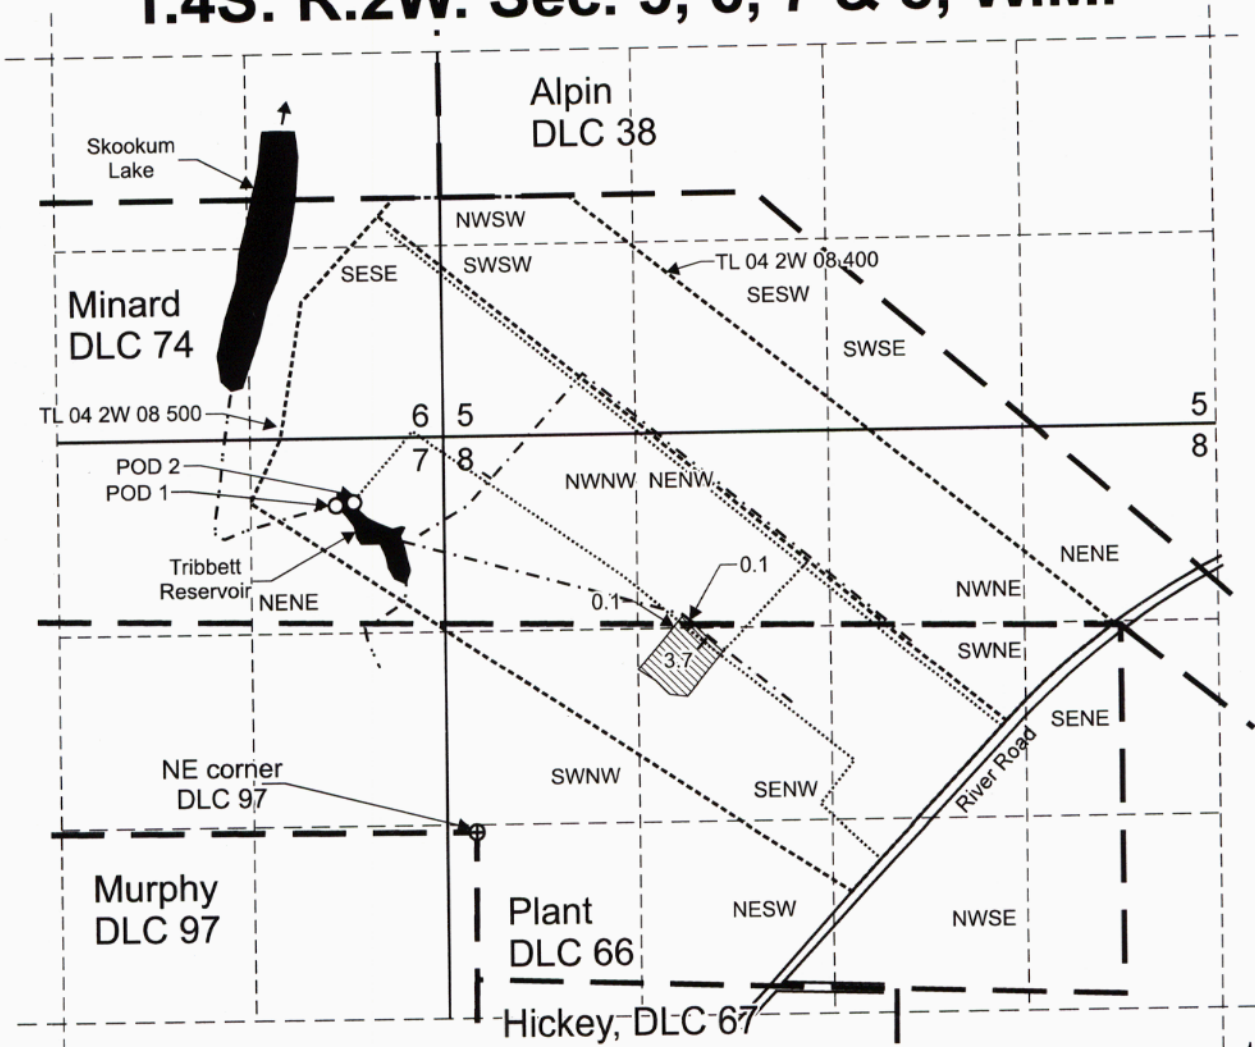

POD 1 is located 2,250 feet north and 940 feet west from the NE corner, DLC 97.

POD 2 is located 2,250 feet north and 820 feet west from the NE corner, DLC 97.

 Area (3.9 acres) of supplemental irrigation under T-10618, formerly Certificates 40585, priority date 5-15-1967.

- Tax lot boundary
- ■ — Donation Land Claim boundary
- - - - 6 inch Water main line, to the pond
- 6 inch Water main line, to the place of use

Scale: 1" = 1,320'



This map was prepared for the purpose of identifying the location of a water right only and is not intended to provide legal dimensions or location of property ownership lines.

Claim of Beneficial Use Map
T-10618, formerly Certificate 40585

Pacific Hydro-Geology Inc.

11/2024
Rev. 06/2025

Kelly Farms, Inc.
T.4S, R. 2W. Sec. 5. 6. 7 & 8 , W.M.