



T.4S. R.2W. Sec. 5, 6, 7 & 8, W.M.

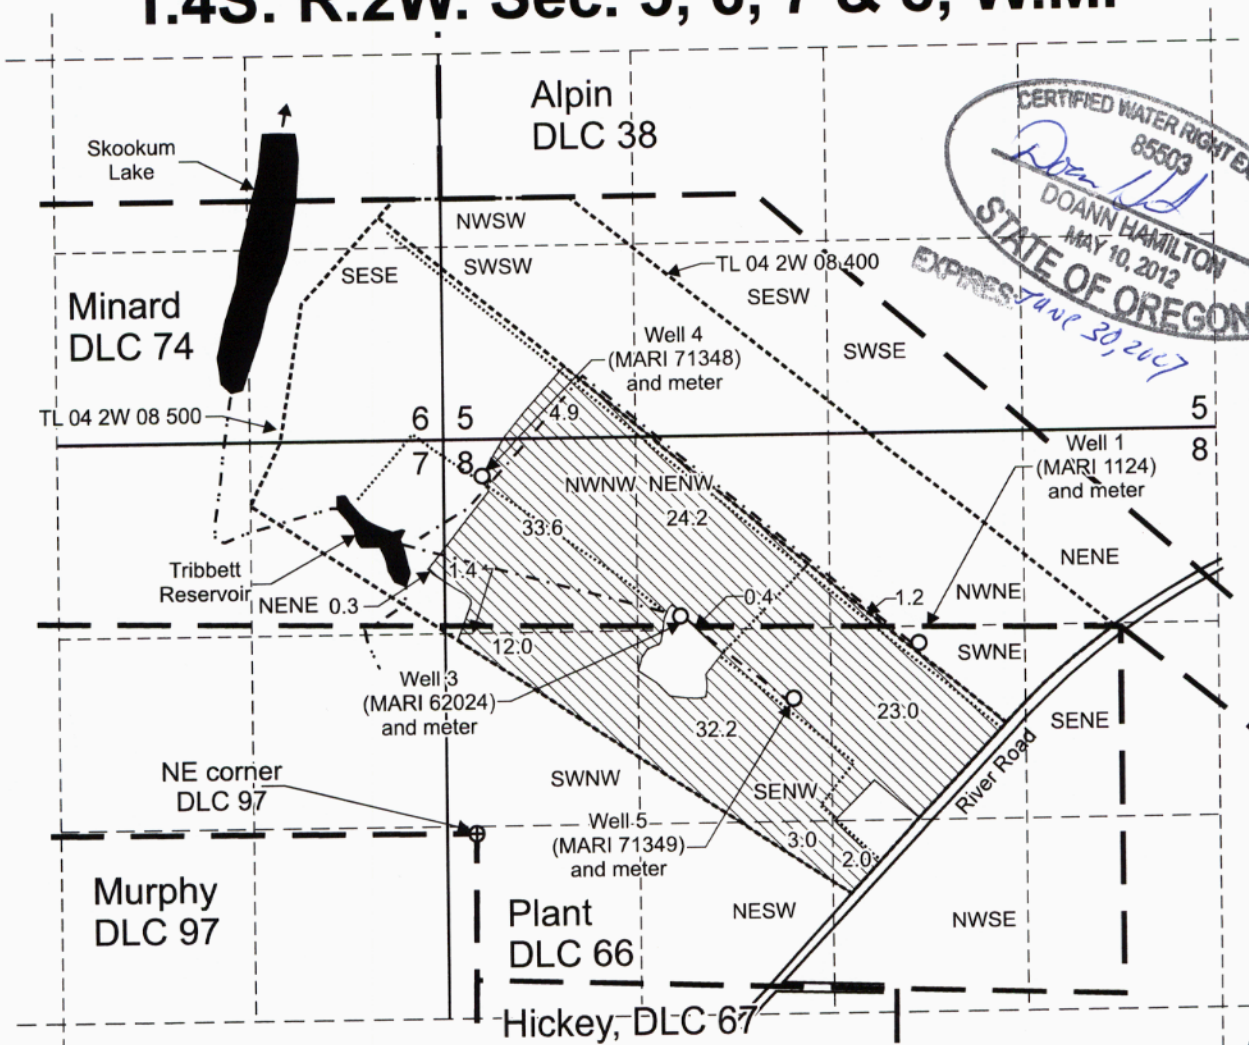

Well 1 (MARI 1124) is located 1,260 feet north and 3,040 feet east from the NE corner, DLC 97.
Well 3 (MARI 62024) is located 1,470 feet north and 1,410 feet east from the NE corner, DLC 97.
Well 4 (MARI 71348) is located 2,440 feet north and 60 feet east from the NE corner, DLC 97.
Well 5 (MARI 71349) is located 890 feet north and 2,180 feet east from the NE corner, DLC 97.

 Area (138.2 acres) of primary irrigation under T-10618, formerly Certificate 40865, priority date: 7-22-1960

- Tax lot boundary
- — — — — Donation Land Claim boundary
- - - - - 6 inch Water main line, to the pond
- 6 inch Water main line, to the place of use

Scale: 1" = 1,320'



This map was prepared for the purpose of identifying the location of a water right only and is not intended to provide legal dimensions or location of property ownership lines.

Claim of Beneficial Use Map
T-10618, formerly Certificate 40865

Pacific Hydro-Geology Inc.

11/2024
Rev. 06/2025

Kelly Farms, Inc.
T.4S, R. 2W. Sec. 5. 6. 7 & 8, W.M.

Received
JUN 09 2025
OWRD