


RENEWAL DATE 12/31/2021

T23S R33E, WM,
HARNEY COUNTY, OR



0 1,320 Feet

1" = 1320'

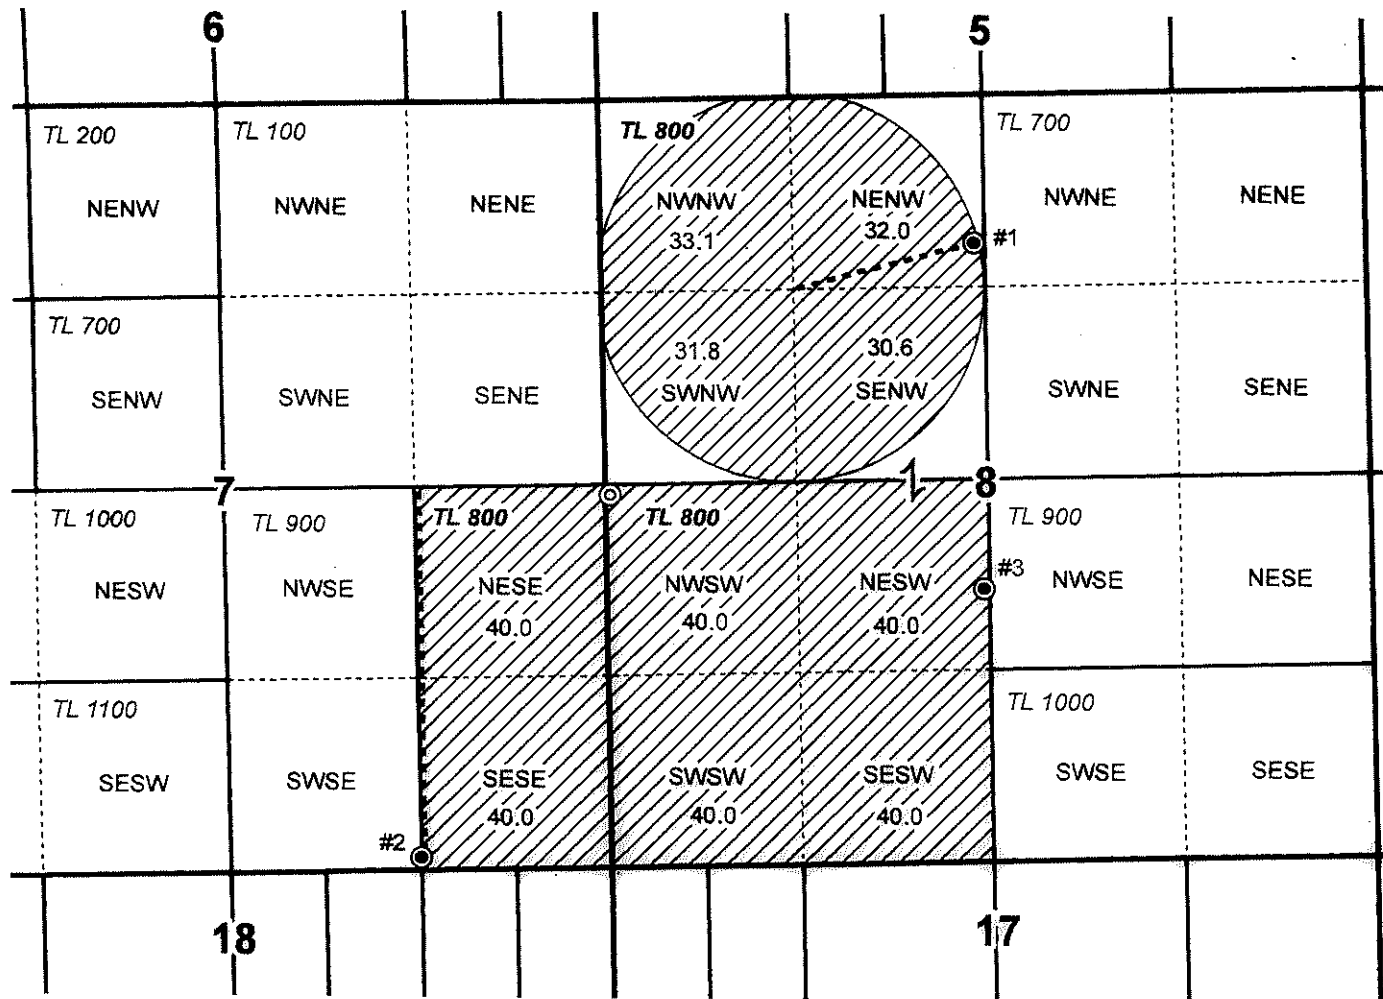

- Well & Meter
- ⊙ Observation Well L-125166
- Pipeline
- POU IR
- Section
- Quarter Quarter
- Tax Lot

Well Locations:

Well #1 (HARN 51931/L-109956):
1010' S, 50' W of N 1/4 Cor Sec 8

Well #2 (HARN 51932/L-109957):
60' N, 1310' W of SE Cor Sec 7

Well #3 (HARN 51883/L-96849):
750' S, 20' W of Center Sec 8

Observation Well (HARN 52665/L-125166):
70' S, 30' E of E 1/4 Cor Sec 7

CLAIM OF BENEFICIAL USE MAP
Mike & Virginia Taylor

Ap. G-17722 Permit G-17373

Project #20021

Date: 6/8/2020

This map is not intended
to provide legal dimensions
or locations of property
ownership lines.

WATER RIGHT SERVICES, LLC
PO BOX 1830, BEND, OR 97709
WWW.OREGONWATER.US CCB # 197121
johnshort@usa.com 541-389-2837