


RENEWAL DATE 12/31/2021

T23S R33E, WM,
HARNEY COUNTY, OR



0 1,320 Feet

1" = 1320'

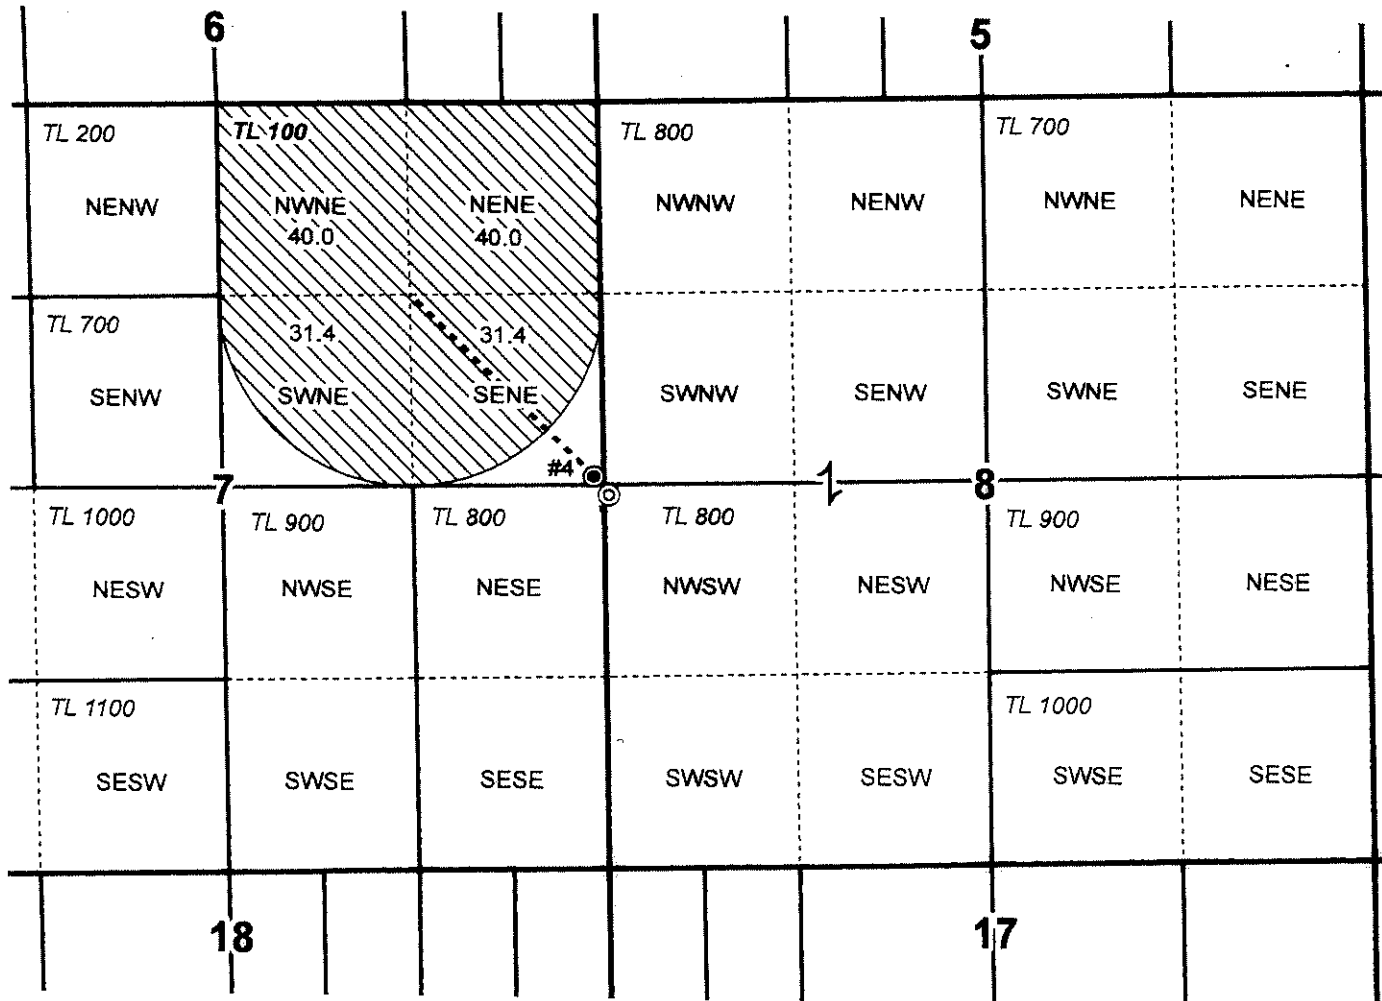

Well Locations:

Well #4 (HARN 52879/L-134220):
60' N, 70' W of E 1/4 Cor Sec 7

Observation Well (HARN 52665/L-125166):
70' S, 30' E of E 1/4 Cor Sec 7

CLAIM OF BENEFICIAL USE MAP
Mike & Virginia Taylor

Ap. G-17777 Permit G-17375

Project #20032

Date: 5/24/2020

This map is not intended
to provide legal dimensions
or locations of property
ownership lines.

WATER RIGHT SERVICES, LLC
PO BOX 1830, BEND, OR 97709
WWW.OREGONWATER.US CCB # 197121
johnshort@usa.com 541-389-2837