


# CLAIM OF BENEFICIAL USE MAP

## TO ADD ADDITIONAL STORAGE FOR ROCK CREEK RESERVOIR

### APPLICATION R-87822

TAX LOT: 900  
TOWNSHIP 22 SOUTH, RANGE 33 EAST, W.M.

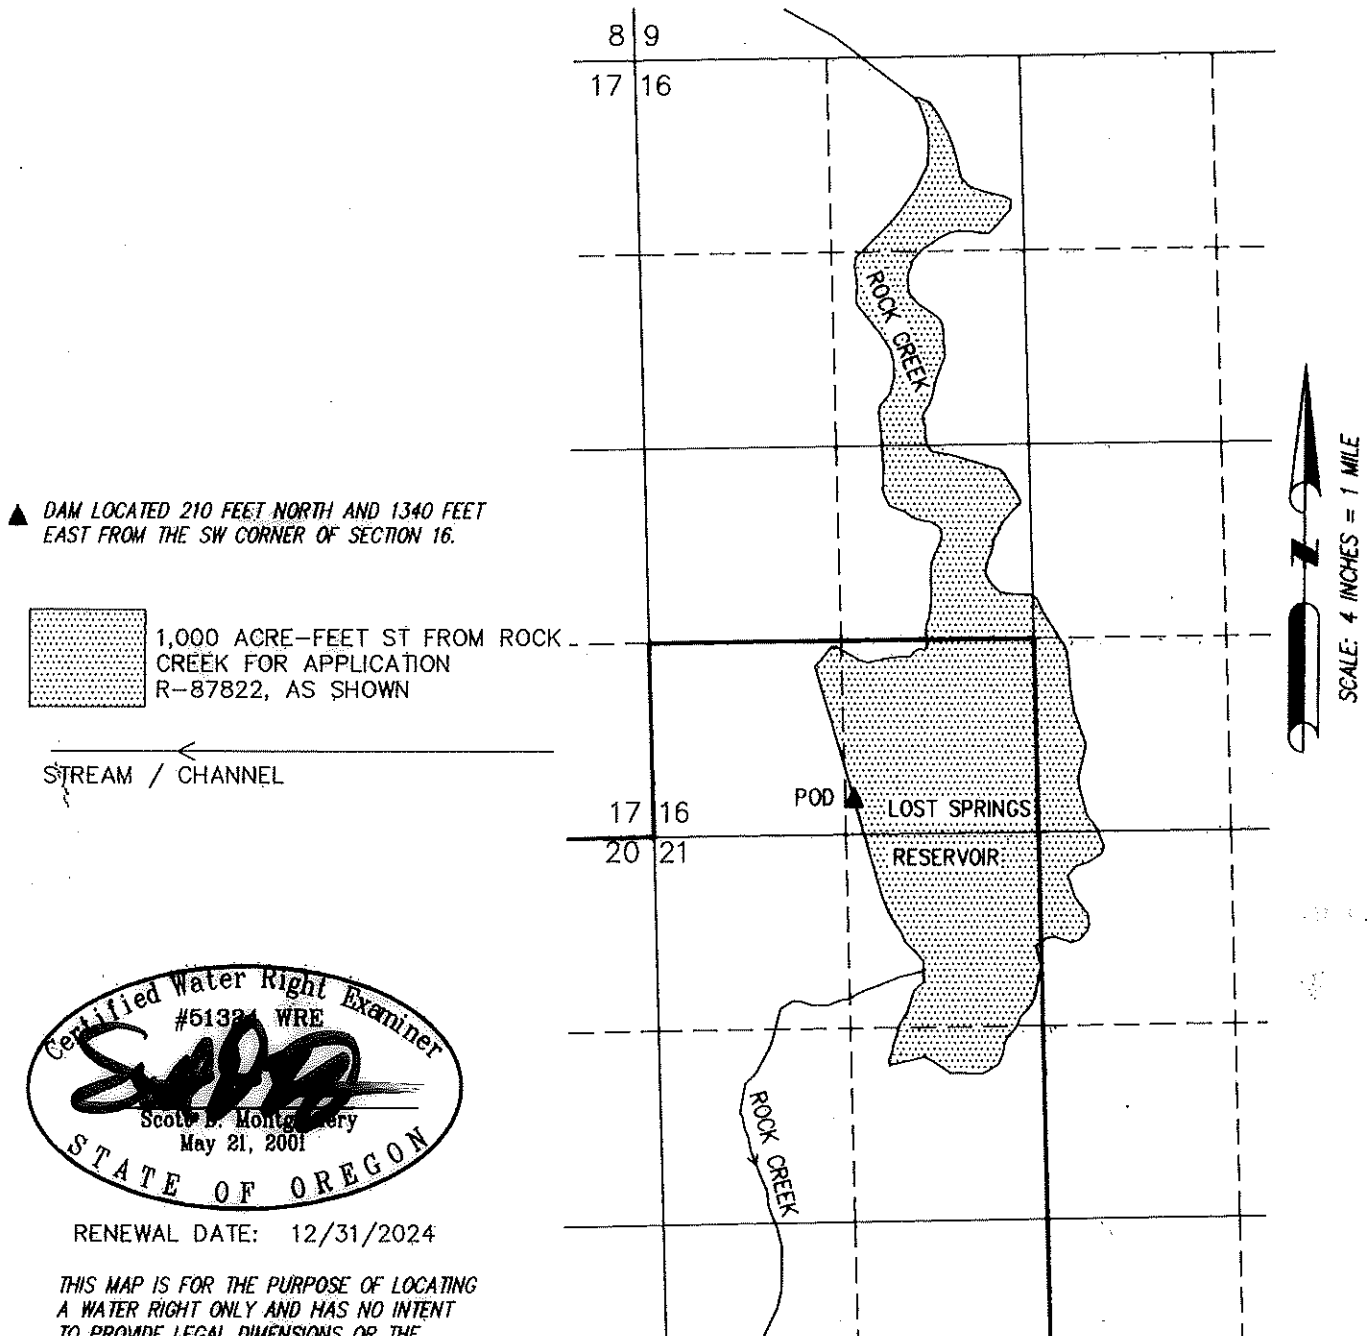

RENEWAL DATE: 12/31/2024

THIS MAP IS FOR THE PURPOSE OF LOCATING  
A WATER RIGHT ONLY AND HAS NO INTENT  
TO PROVIDE LEGAL DIMENSIONS OR THE  
LOCATION OF PROPERTY LINES.

PREPARED FOR:

RATTLESNAKE CREEK LAND & CATTLE  
524 HWY 20N  
HINES, OR 97738

PREPARED BY:



ALL POINTS ENGINEERING AND SURVEYING, INC.  
P.O. BOX 767 TERREBONNE, OR 97760  
(541) 548-5833 [www.APEandS.com](http://www.APEandS.com)