

CLAIM OF BENEFICIAL USE MAP

TO ADD PLACE OF USE AND A POINT OF DIVERSION FOR
APPLICATION S-87823

TAX LOTS: 900, 1700, & 1800 IN SECTIONS 20, 21, 28, 29, 30, 31, & 32,
TOWNSHIP 22 SOUTH, RANGE 33 EAST, W.M.


RECEIVED
SEP 05 2023
OWRD

▲ POD LOCATED 210 FEET NORTH AND 1340 FEET
EAST FROM THE SW CORNER OF SECTION 16.

1,505.9 ACRES IS FROM POD FOR
APPLICATION S-87823, AS SHOWN

STREAM / CHANNEL
BURIED 6 OR 8 INCH STEEL PIPE

SCALE: 4 INCHES = 1 MILE

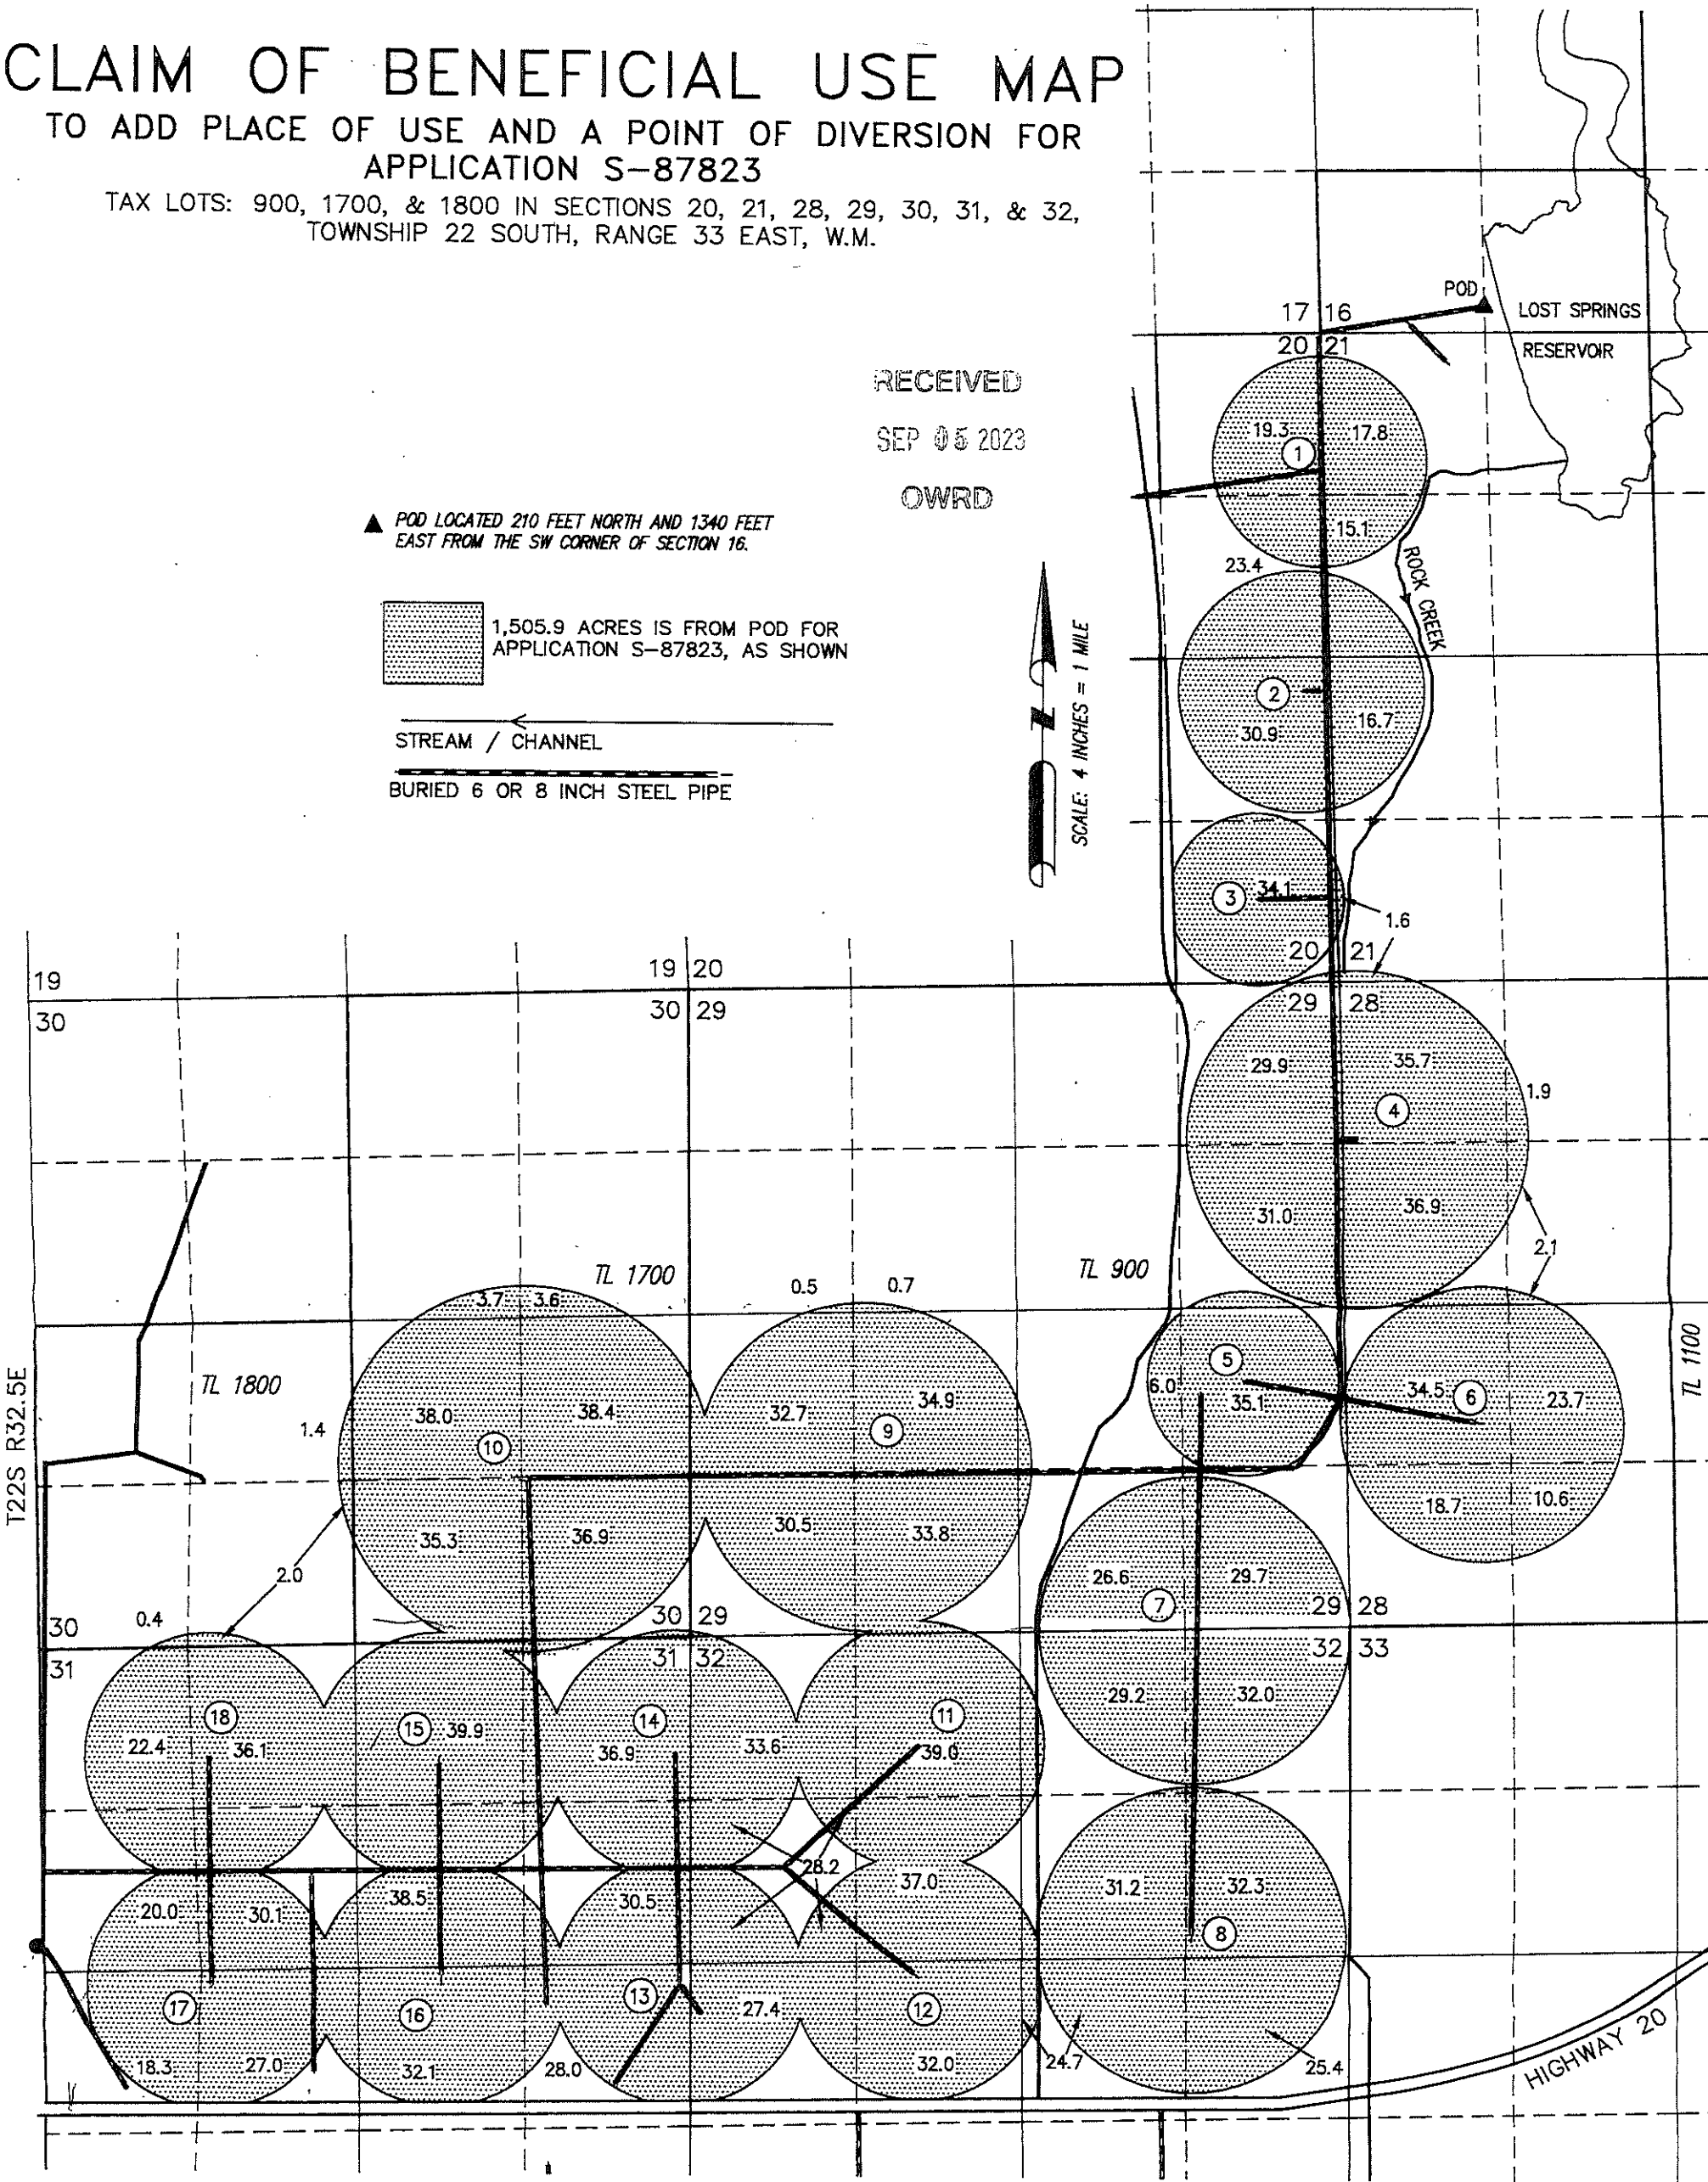

PREPARED FOR:


RATTLESNAKE CREEK LAND & CATTLE
524 HWY 20N
HINES, OR 97738

PREPARED BY:



ALL POINTS ENGINEERING AND SURVEYING, INC.
P.O. BOX 767
(541) 548-5833
www.APEandS.com

TERREBONNE, OR 97760

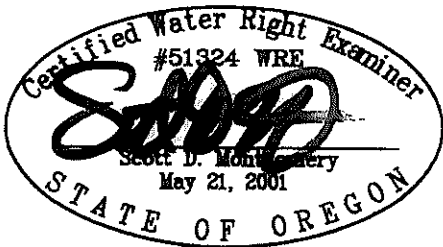

RENEWAL DATE: 12/31/2024

THIS MAP IS FOR THE PURPOSE OF LOCATING
A WATER RIGHT ONLY AND HAS NO INTENT
TO PROVIDE LEGAL DIMENSIONS OR THE
LOCATION OF PROPERTY LINES.