


SEC. 35, T. 8 S., R. 40 E., W.M.

THIS MAP IS NOT INTENDED TO
PROVIDE LEGAL DIMENSIONS OR
LOCATIONS OF PROPERTY OWNER-
SHIP LINES.

1" = 400'

LEGEND:

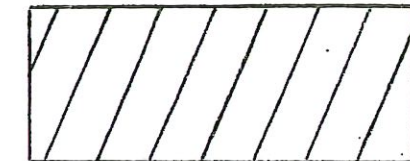

IRRIGATED LAND

CLAIM OF BENEFICIAL USE MAP

APPLICATION G-16937

PERMIT G-16469

IN THE NAME OF

FRED & LAURIE McADAMS

FEB. 22, 2021

RECEIVED

MAR 01 2021

OWRD



SEC. 2, T. 9 S., R. 40 E., W.M.

