


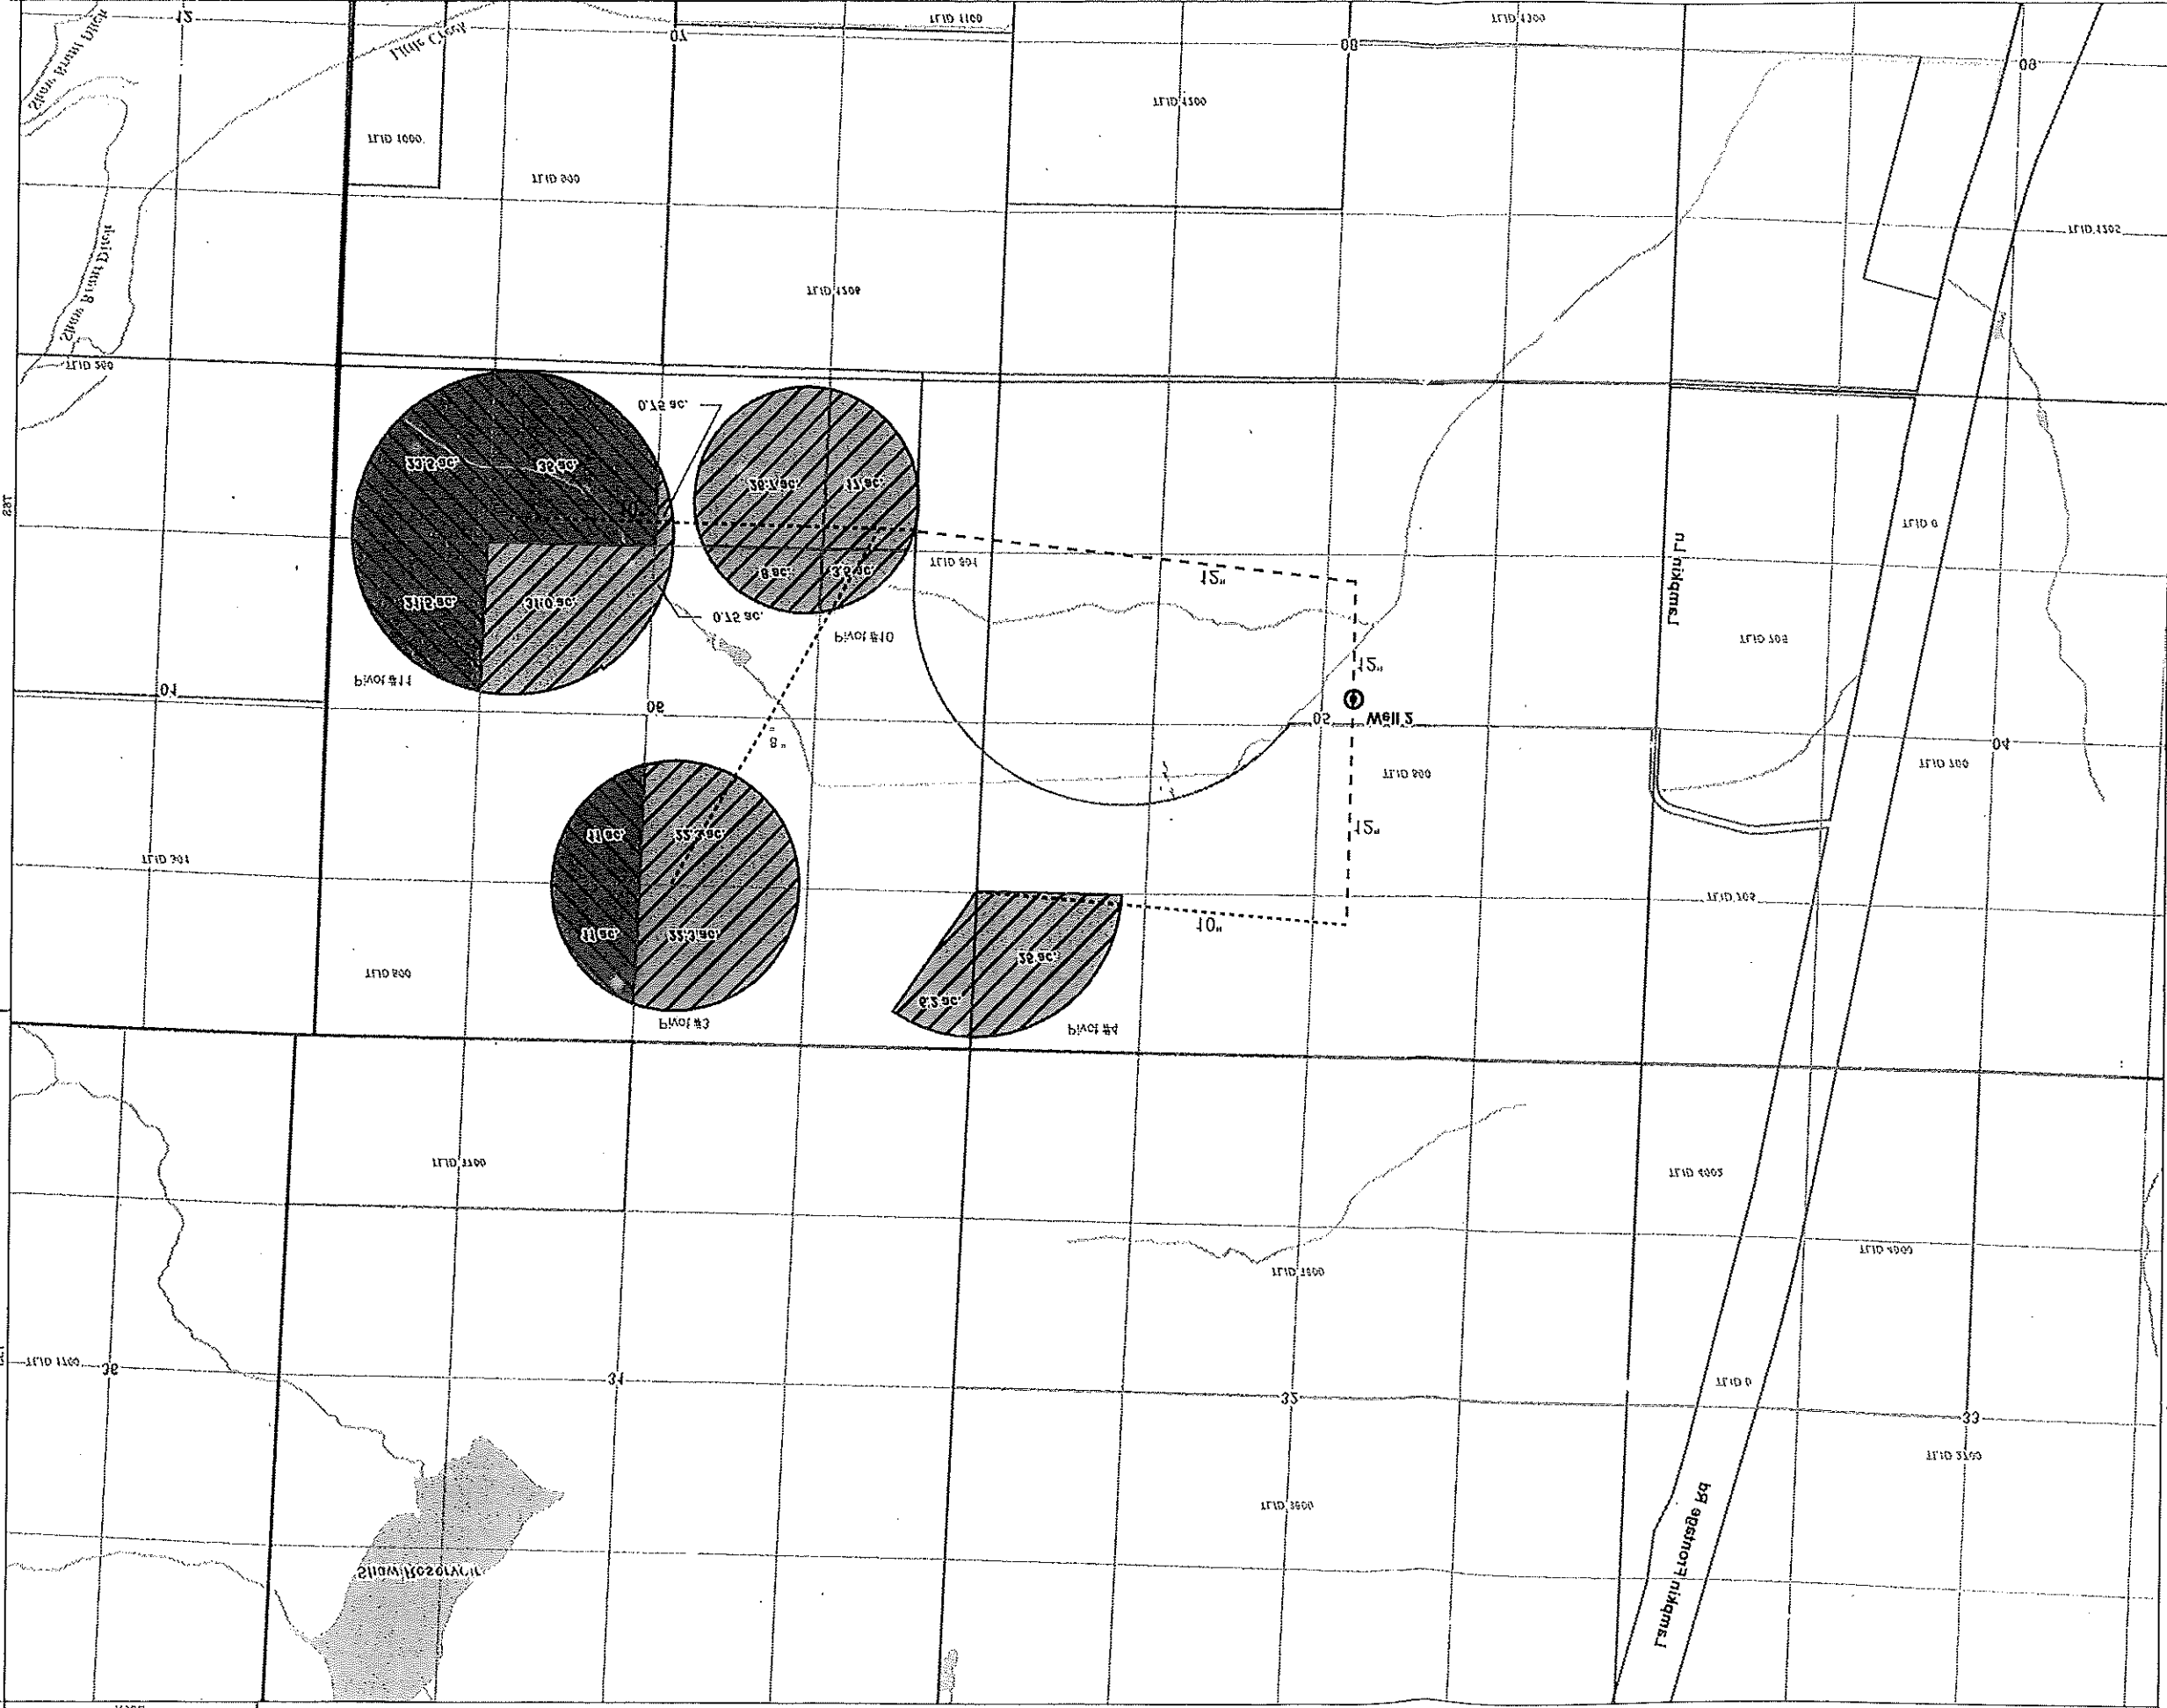

Union Co.
Date: 05/08/55
Date: 05/08/55
Map Notes
Legal dimensions or location of property ownership lines.
Location of a water right only and it is not intended to provide
This map was prepared for the purpose of identifying the
Disclaimer

0 660 1'350 1'660

EXPIRES: 5/30/5055

STATE OF OREGON
JUNE 3, 2018
JOHN H. HARRIS
CERTIFIED WATER RIGHTS EXAMINER

Certified Water Rights Examiner Stamp

Number corner of section 8, Township 8 South, Range 33 East (W.M.)
Well 3: located 500 feet East from the East
AUTHORIZED POINT OF APPROPRIATION

--- 15" Buried Mainline
--- 10" Buried Mainline
Waterbody
Watercourse
Tax lot
All Other Data
Supplemental (183.2 Acres)
Primary (105 Acres)
Place of Use (POU)
Authorized Well and Flowmeter

LEGEND

Union County, Oregon
T. 8 S. & 33 E. (W.M.)
Permit G-11131
Ap # G-11025
for Deputy (220 Land)
Final Plot Survey Map