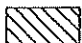


T.4S. R.2E. Section 30, W.M.

Well (CLAC 63545) is located 50 feet south and 595 feet east from the center corner, Section 30.

 Area (12.4 Acres) of nursery operation under Application G-16513, Permit G-16116.

----- Tax lot boundary



— Donation Land Claim boundary

..... Water main line
(A = above ground, B = below ground)


RECEIVED

JUN 06 2012


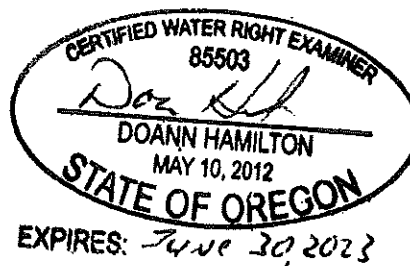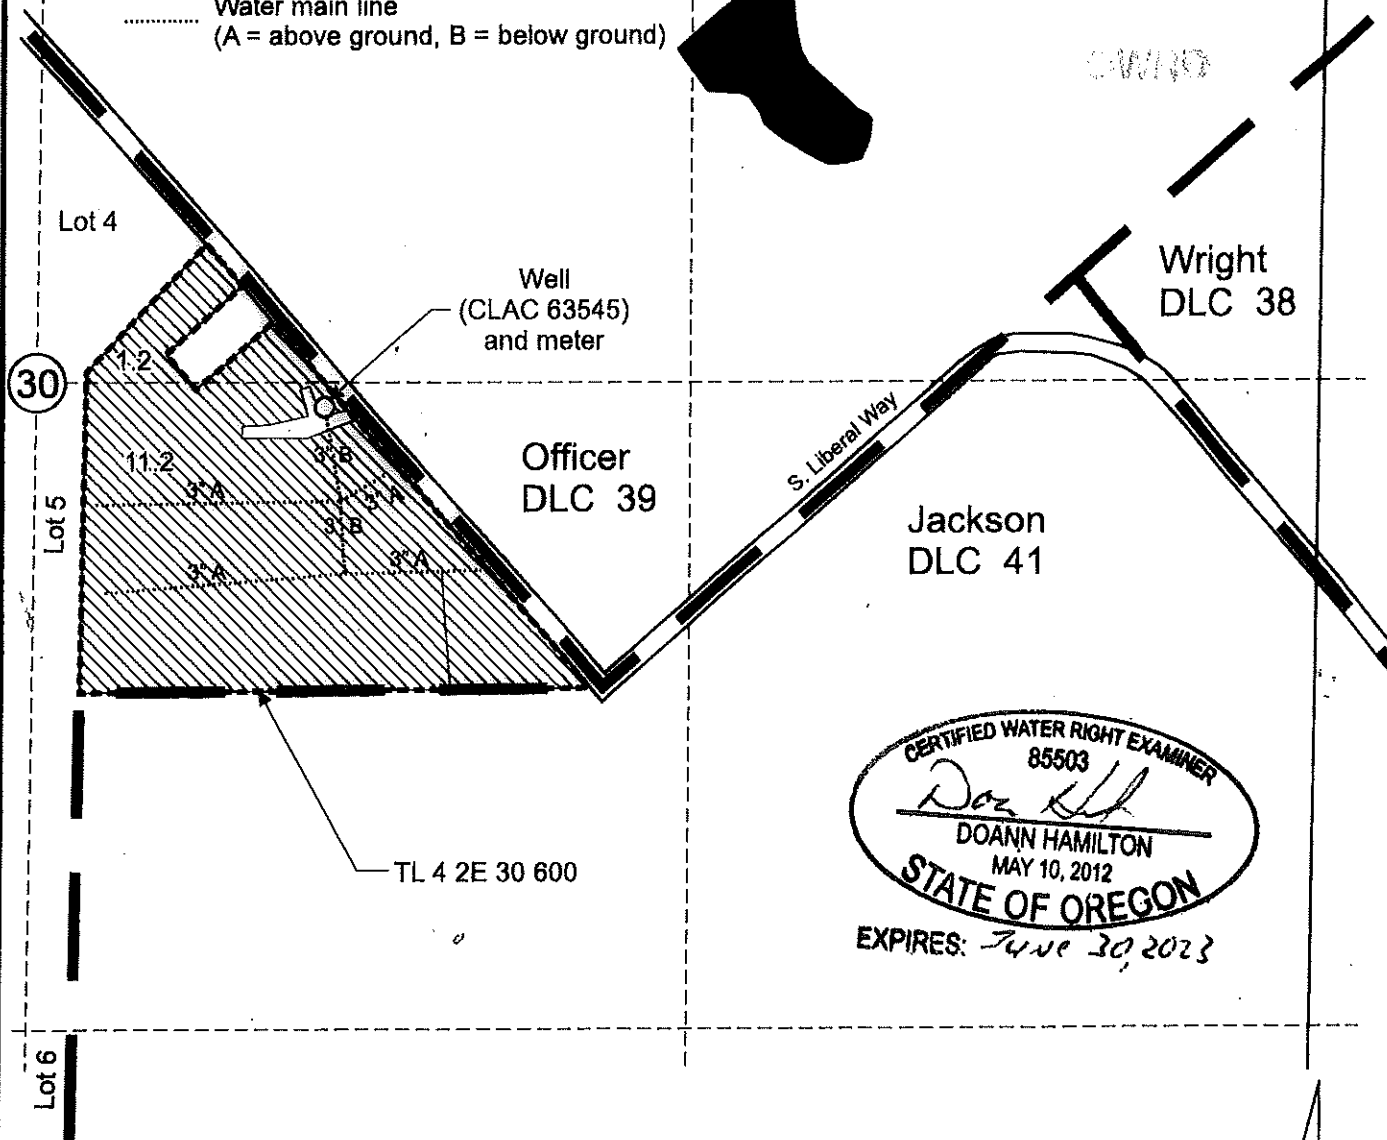

Scale: 1" = 400'

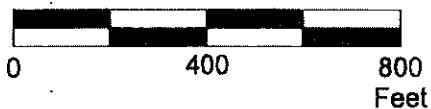

This map was prepared for the purpose of identifying the location of a water right only and is not intended to provide legal dimensions or location of property ownership lines.

Claim of Beneficial Use Map
Application G-16513, Permit G-16116

Ubaldo and Maria Sanchez
T.4S. R.2E. Section 30, W.M.

Pacific Hydro-Geology Inc.

05/2022