

TRANSFER APPLICATION MAP  
CHANGE IN POINT OF DIVERSION & ADDITIONAL POINT OF DIVERSION  
FOR

T.13S., R.32E. S35 S36  
T.14S., R.32E. S1

GOV'T LOT 3

GOV'T LOT 2

GOV'T LOT 1 (100)

(200)

0.6

23.3

0.9

2.1

PONDS

FOUND BRASS CAP

(200)

(400)

NE1/4 SW1/4

2.0

1.0

NW1/4 SE1/4

NOTE:  
5.3 AC. R.R.  
IN NW1/4SE1/4

(200)

(600)

FOUND BRASS CAP

SE1/4 SW1/4

0.5

0.2

BEAR GULCH

PINE CREEK

OWRD

- DISCLAIMER: THIS MAP IS NOT INTENDED TO PROVIDE LEGAL DIMENSIONS OR LOCATIONS OF PROPERTY OWNERSHIP LINES.

Certified Water Right Examiner  
# 009  
*Robert D. Baggett*  
Robert D. Baggett  
Nov. 19, 1987  
STATE OF OREGON


RENEWS 12/31/2025

14380 -



0.534

T.14S., R.32E., W.M.

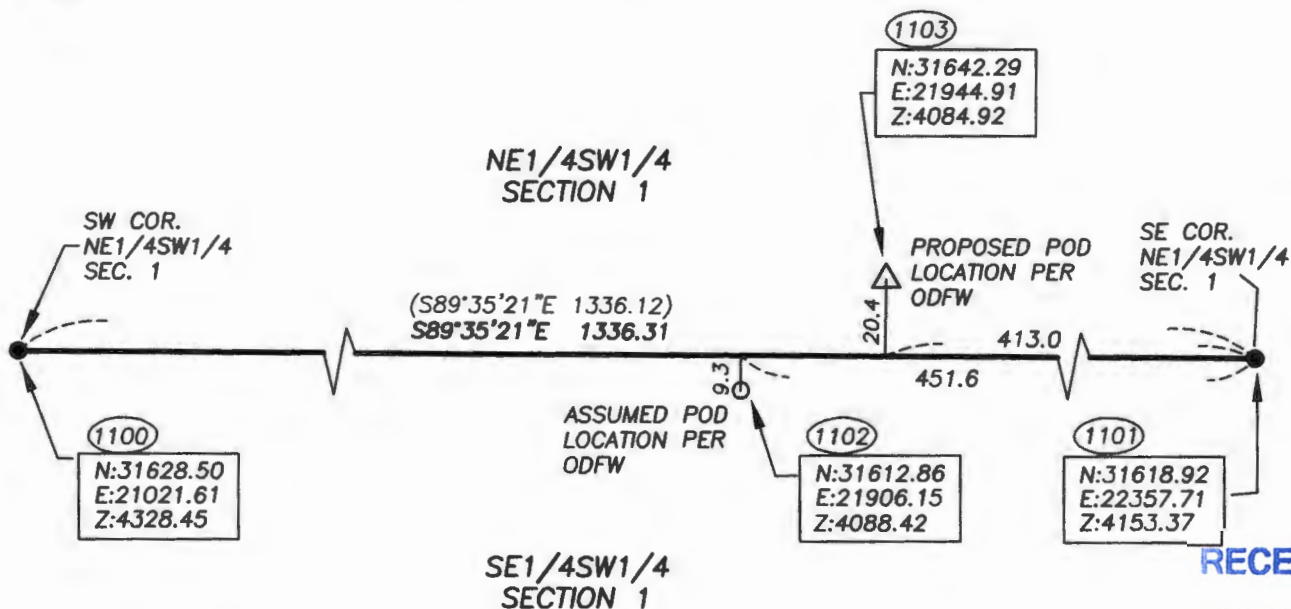

RECEIVED

DEC 22 2023

OWRD

## LEGEND

- FOUND BRASS CAP
- △ FOUND 1/2" REBAR
- FOUND 1/2" REBAR
- ( ) RECORD BEARING AND DISTANCE
- ### POINT NO.

REGISTERED  
PROFESSIONAL  
LAND SURVEYOR

OREGON  
MICHAEL C. SPRINGER  
#70918

EXPIRES: 6/30/2024



BENCHMARK LAND SURVEYING  
217 N. CANYON BLVD. JOHN DAY, OREGON  
541-575-1251 ~ benchmarkls.com

MAP SHOWING RELATIVE POSITION OF POINT NUMBERS  
1102 & 1103 TO THE SOUTH LINE OF THE NE1/4SW1/4  
SECTION 1, T.14S., R.32E., W.M., GRANT COUNTY, OREGON

|               |                          |            |
|---------------|--------------------------|------------|
| SURVEYED FOR  | ROBERT BAGETT, PLS, CWRE |            |
| SURVEYED BY   | MCS                      | 12/15/2022 |
| SCALE: 1"=50' | DRAWN BY: MCS            |            |

14380 -