


SUPERSEDING

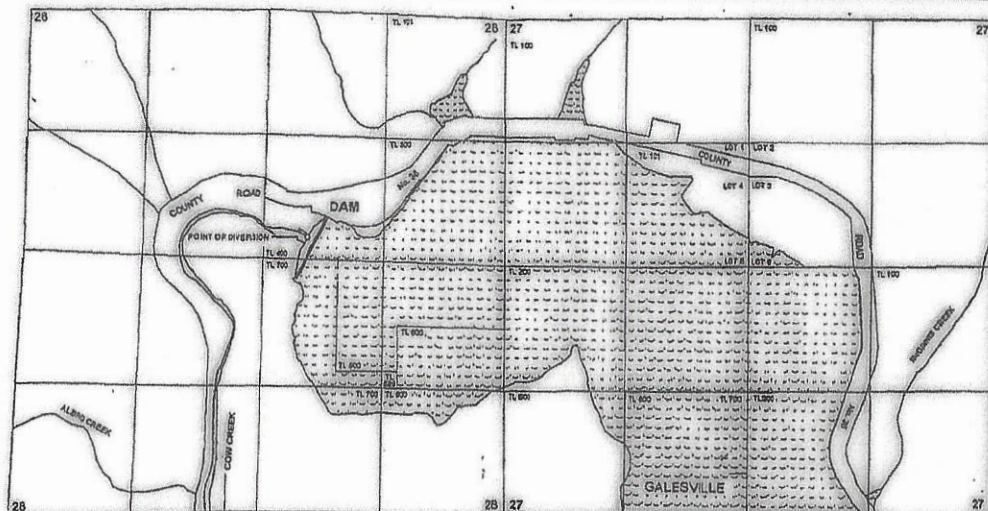

**APPLICATION FOR A WATER RIGHT TRANSFER
IN THE NAME OF
DOUGLAS COUNTY NATURAL RESOURCES**

PERMIT No. R - 9964

CERTIFICATE No. 91395

TOWNSHIPS 31 AND 32 SOUTH, RANGE 4 WEST, W.M.

THE GALESVILLE DAM (RESERVOIR) OUTLET OR POINT OF DIVERSION IS LOCATED
100 FEET NORTH AND 3030 FEET EAST FROM THE WEST QUARTER CORNER OF
SECTION 28; BEING WITHIN THE SW $\frac{1}{4}$ NE $\frac{1}{4}$ OF SECTION 28, TOWNSHIP 31 SOUTH,
RANGE 4 WEST, W.M.; DOUGLAS COUNTY.

THE COUNTY PROPOSES TO TRANSFER ~~4000~~ ^{16,424} ACRE FEET OF ~~IRRIGATION~~ ^{RECREATION}
STORAGE TO ~~4000~~ ^{16,424} ACRE FEET OF MULTI-PURPOSE STORAGE.

THE PURPOSE OF THIS MAP IS TO IDENTIFY THE LOCATION OF THE WATER RIGHT.
IT IS NOT INTENDED TO PROVIDE INFORMATION RELATIVE TO THE LOCATION OF
PROPERTY OWNERSHIP BOUNDARY LINES.