

NOTES:



1. THIS MAP WAS PREPARED FROM FIELD MEASUREMENTS, NAIP 2020 AERIAL PHOTOGRAPHY, KLAMATH COUNTY TAX MAPS, AND OREGON GLO MAPS.
2. THE PURPOSE OF THIS MAP IS TO IDENTIFY THE LOCATION OF THE WATER RIGHT ONLY, AND IS NOT INTENDED TO PROVIDE DIMENSIONS OR LOCATION OF PROPERTY LINES.
3. DATE OF PRIORITY FOR THIS CERTIFICATE IS FEBRUARY 23, 2007.

WELL LOCATION:

WELL 1 (KLAM 59930): T36S, R7E, SECTION 5 W.M.; 80' SOUTH & 100' WEST FROM THE NORTH 1/4 CORNER OF SECTION 5.

LEGEND

- SECTION LINE
- GOVERNMENT LOT LINE
- TAX LOT LINE
- CANAL/CREEK
- ABOVE GROUND PIPE
- ROAD
- WATER PUMP
- FLOW DIRECTION
- SECTION CORNER
- TAX LOT NUMBER
- GOVERNMENT LOT NUMBER
- POA (WELL)
- SUPPLEMENTAL IRRIGATION UNDER PERMIT G-17005
- CONDITIONAL ACREAGE PER SETTLEMENT AGREEMENT OAH REF. No. WR-11-008 (80.0 ACRES)
- IRRIGATED ACRES
- 1/4 1/4 SECTION
- IRRIGATED ACRES
- GOVERNMENT LOT NUMBER

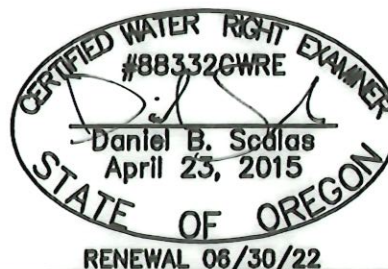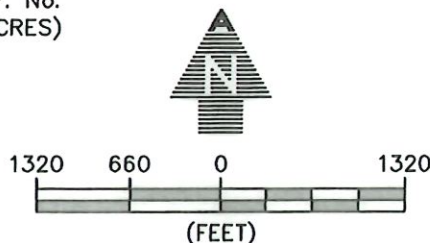

RECEIVED
DEC 30 2020
OWRD

AL ADKINS
ENGINEERING & SURVEYING

o / 541.884.4666
w / AdkinsEngineering.com

1435 ESPLANADE AVENUE, KLAMATH FALLS, OR 97601

SERVING S. OREGON & N. CALIFORNIA

ENGINEERING • SURVEYING • PLANNING • TESTING

2666-0102

CLAIM OF BENEFICIAL USE AND FINAL PROOF MAP

FOR
LOREN WALCH AND MELINDA CAUVIN
T36S, R7E, SECS. 5, 6, 8, & 9, WM
KLAMATH COUNTY, OREGON
PERMIT G-17005
APPLICATION G-16804