




T.7S. R.1W. Section 5, W.M.

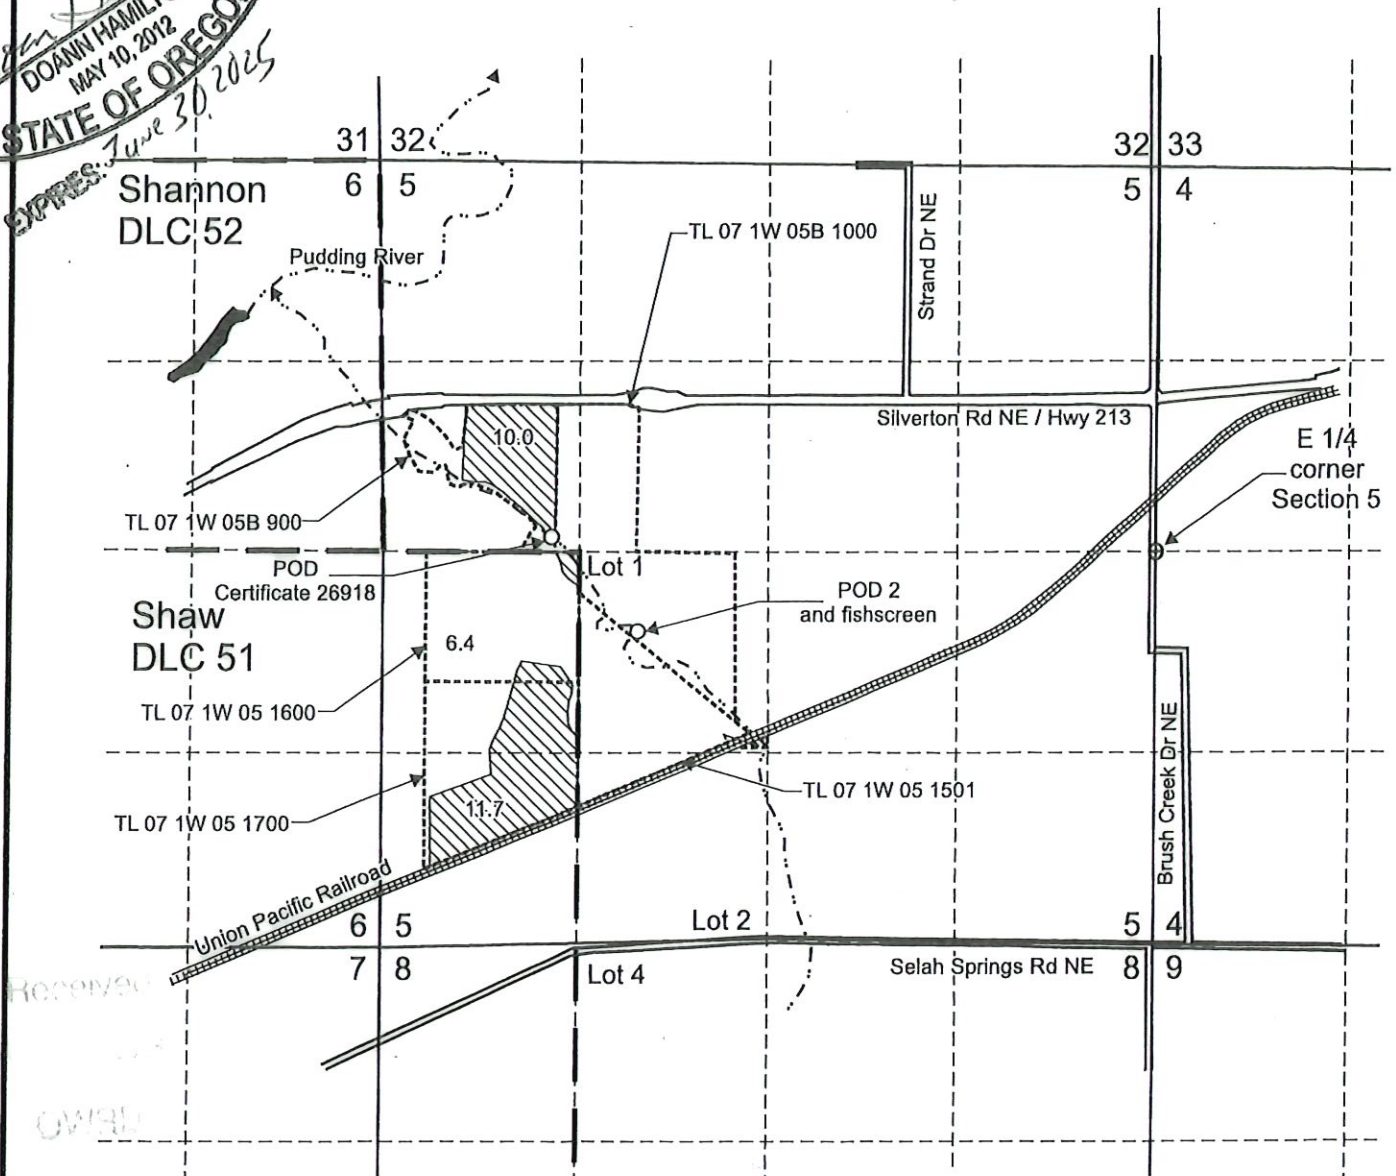

POD from unnamed stream: No coordinates given. Re-described per Certificate 62138: 90 feet north and 4,080 feet west from the E 1/4 corner, Section 5.

POD 2 is located 500 feet south and 3,520 feet west from the E 1/4 corner, Section 5.


 Area (28.1 Acres) irrigated under T-13620, formerly Certificate 26918, priority date: June 26, 1951.

----- Tax lot boundary

— ■ — Donation Land Claim boundary

5 and 6 inch mainlines are portable

Scale: 1" = 1,320'

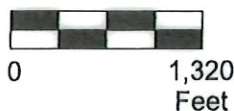

This map was prepared for the purpose of identifying the location of a water right only and is not intended to provide legal dimensions or location of property ownership lines.

Claim of Beneficial Use Map
T-13620, formerly Certificate 26918

Pacific Hydro-Geology Inc.

02/2024

Blue Line Farms, Inc.
T.7S. R.1W. Section 5, W.M.