

POD Location:
Spring #2: 1490' S, 640' W of E 1/4 Cor Sec 14

T7N R9W, WM,
CLATSOP COUNTY, OR

SWNE

SENE

SWNW



0 400
Feet

1" = 400'

1100

1102

500

Klaskanine River

Youngs River Rd

1100

1103

800

NWSE

NESE

801

801

NWSW

1101

Section 14

Section 13

- Storage Tank
- POD - ANTHONY
- River/Stream
- DOMESTIC USE POU - ANTHONY
- Section
- Quarter Quarter
- Tax Lot



RENEWAL DATE 12/31/2023

SESE #2

Received

APR 29 2024

OWRD



CLAIM OF BENEFICIAL USE MAP
William & Christina Anthony

Date: 12/4/2023 Ap S-84752 Permit S-53848 Priority 5/9/2001


Project #23057

This map is not intended
to provide legal dimensions
or locations of property
ownership lines.

WATER RIGHT SERVICES, LLC
PO BOX 1830, BEND, OR 97709
WWW.OREGONWATER.US CCB # 197121
johnshort@usa.com 541-389-2837

**T7N R9W, WM,
CLATSOP COUNTY, OR**

POD Location:
Spring #1: 880' S, 1610' W of E 1/4 Cor Sec 14

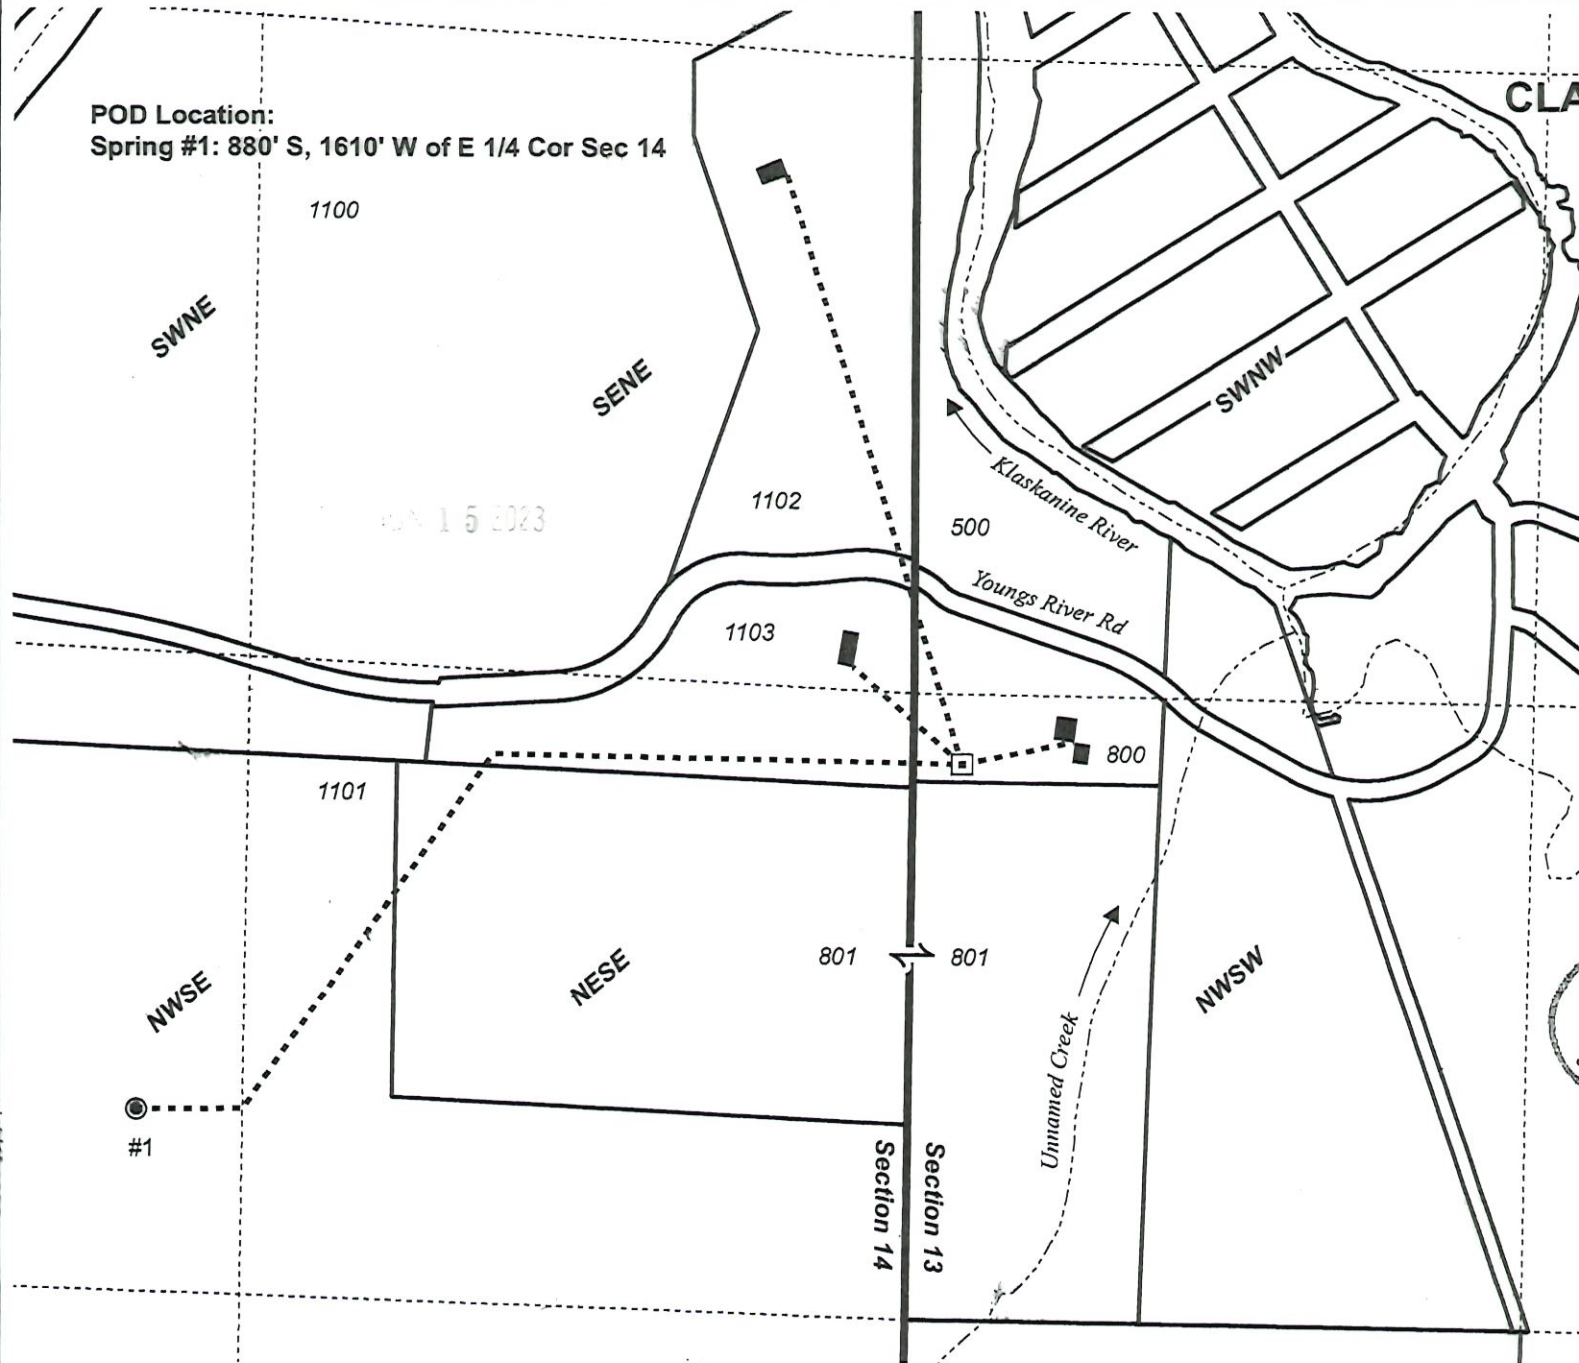

- 0 400 Feet
1" = 400'
- ⊙ POD
 - Storage Tanks
 - River/Stream
 - Pipeline
 - POU DM
 - Section
 - - - Quarter Quarter
 - Tax Lot



RENEWAL DATE 12/31/2023



CLAIM OF BENEFICIAL USE MAP
Luke Colvin

Date: 5/4/2023 Ap S-84752 Permit S-53848 Priority 5/9/2001 Project #23011

This map is not intended
to provide legal dimensions
or locations of property
ownership lines.

WATER RIGHT SERVICES, LLC
PO BOX 1830, BEND, OR 97709
WWW.OREGONWATER.US CCB # 197121
johnshort@usa.com 541-389-2837