

T.5S. R.1E. Section 2, W.M.

T.4S. Barnards Road
T.5S.

Well (CLAC 76245) is located 245 feet north and 370 feet east from the center quarter corner, Section 2.

 Area (12.3 Acres) covered under nursery use, Application G-18571, Permit G-18846, T-13680.


----- Tax lot boundary

..... Water main line

Received

JAN 23 2025

OWRD

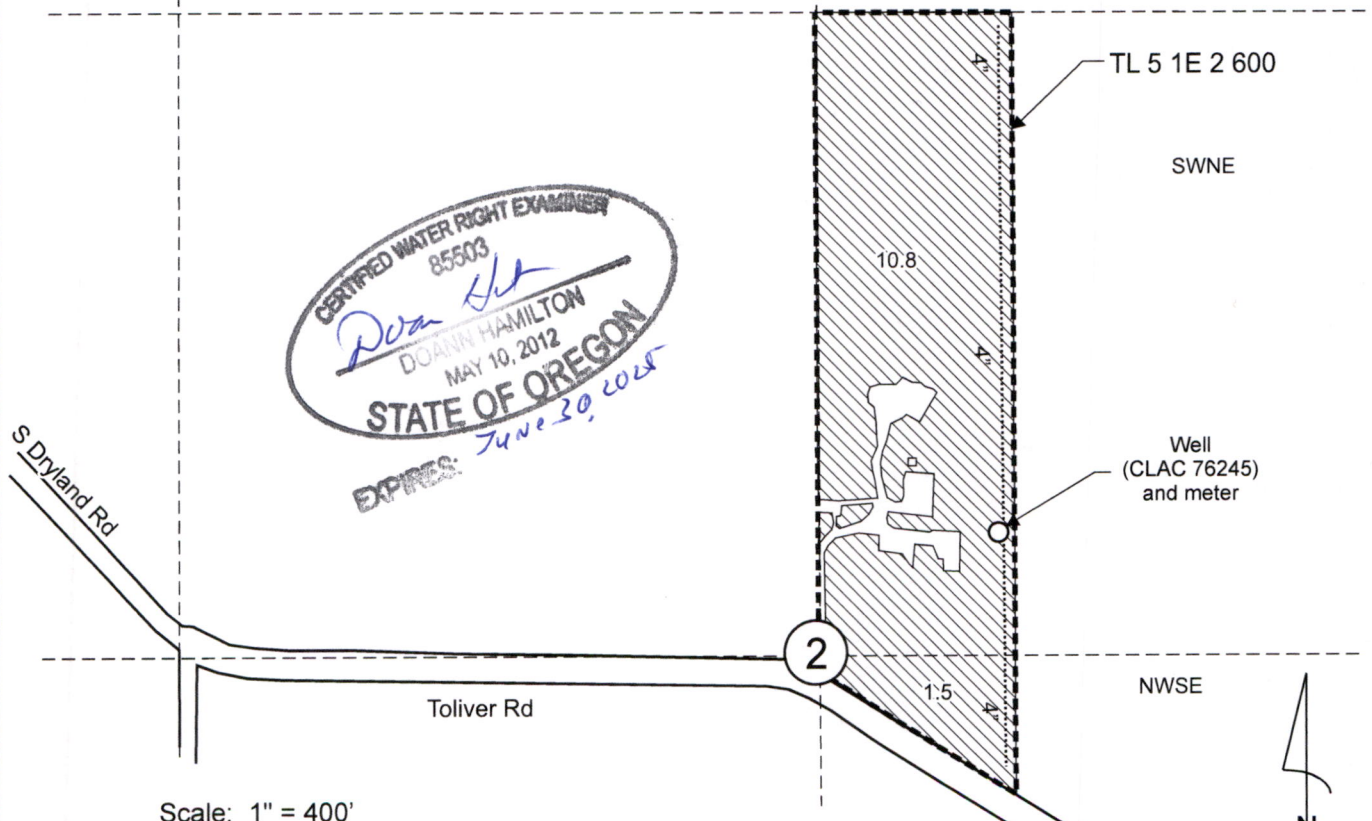

This map was prepared for the purpose of identifying the location of a water right only and is not intended to provide legal dimensions or location of property ownership lines.

Claim of Beneficial Use Map
Application G-18571, Permit G-18846, T-13680

Pacific Hydro-Geology Inc.

Dan and Dawn Staley
T.5S R.1E. Section 2, W.M.

01/2025