

T.4S. R.1E. Section 10, W.M.


Goode Ln

Well 4 (CLAC 78798) is located 95 feet north and 1,000 feet east from the SW corner, Section 10.

 Area (9.56 Acres) of nursery operations under T-12876, formerly Certificate 87775, priority date 8-14-2021.


----- Tax lot boundary

..... Water main line

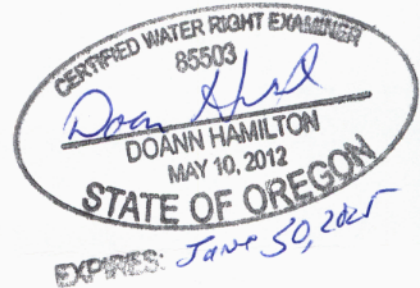


SWSW

SESW

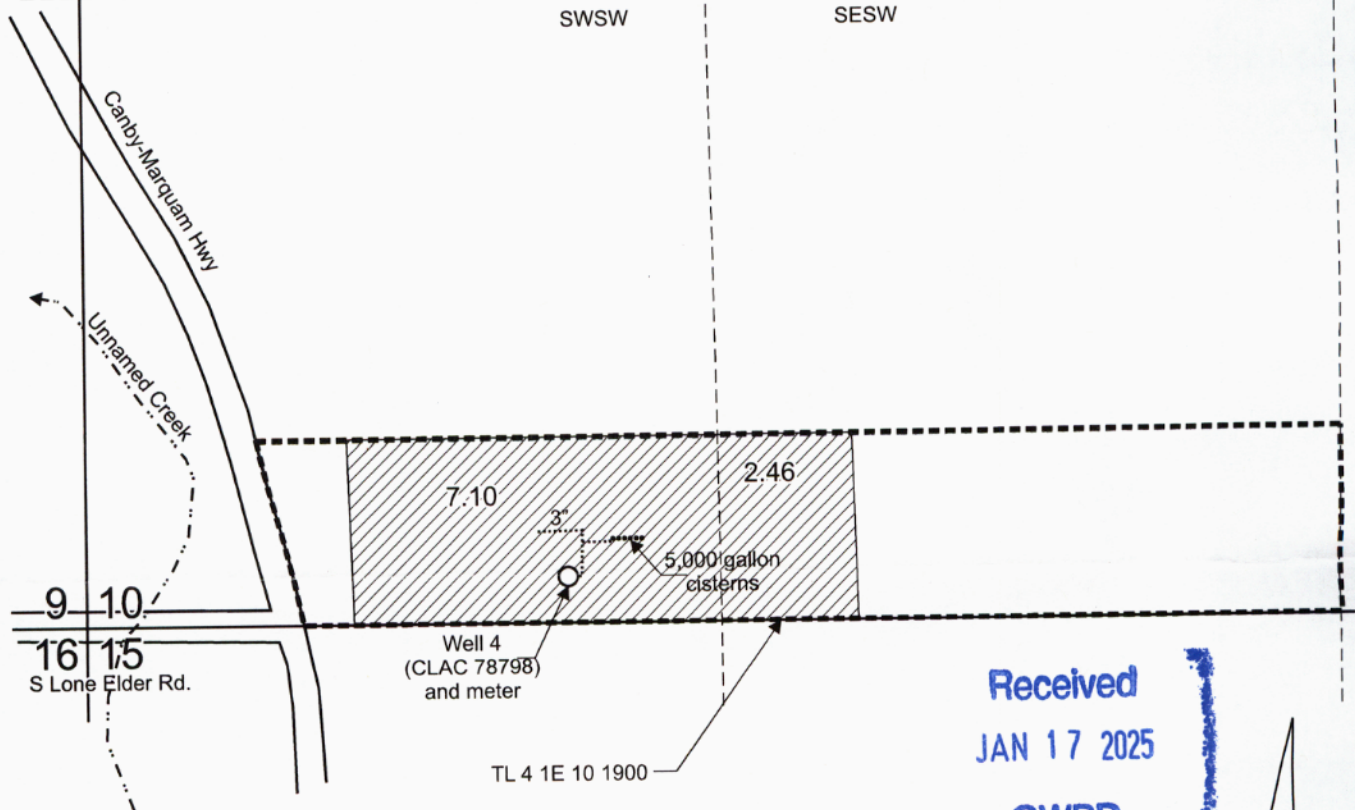

Scale: 1" = 400'

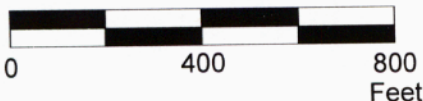

This map was prepared for the purpose of identifying the location of a water right only and is not intended to provide legal dimensions or location of property ownership lines.

Claim of Beneficial Use Map
T-12876, formerly Certificate 87775

Horta Latitude 45, LLC c/o George Xidias
T.4S. R.1E Section 10, W.M.

Pacific Hydro-Geology Inc.

11/2024

XidiasT-12876COBUmap.cdr