


T. 6N., R. 35E., W. M.

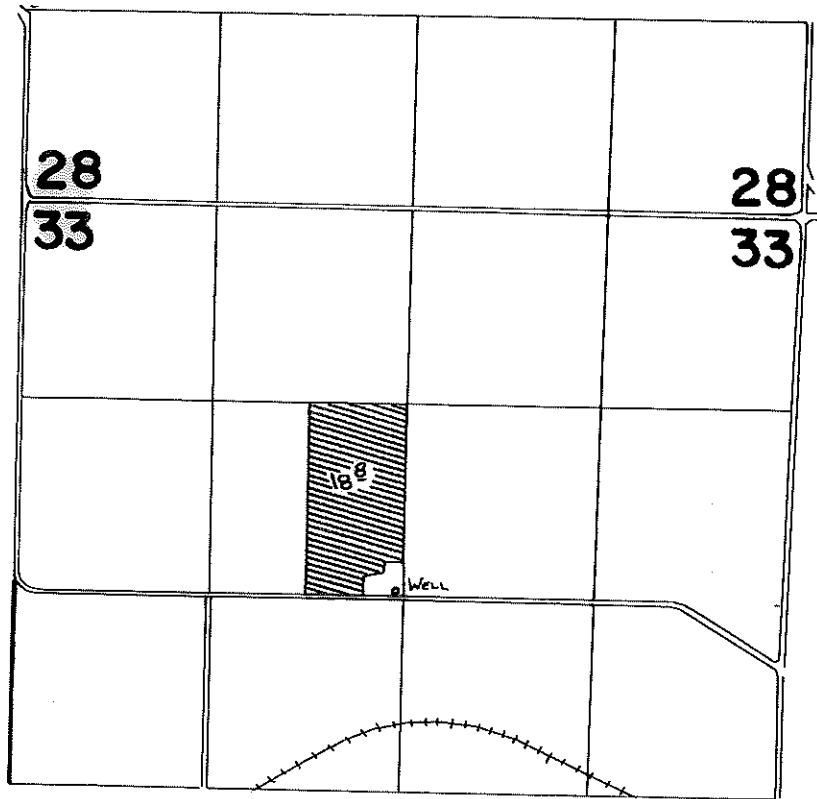

WELL LOCATED 50' N. & 60' W. FROM CENTER COR. SEC. 33



SCALE: 1" = 132'

FINAL PROOF SURVEY UNDER

Application No. G:11013.. Permit No. G:10119...
IN NAME OF

.....M. A. PESCIALLO.....

Surveyed 10-24..... 1984, by V. L. Church.....