


T1S R4E Sec 26 & 27

Application: G-15936
Permit: G-18278
Transfer: T-13149

RECEIVED
DEC 04 2020
OWRD

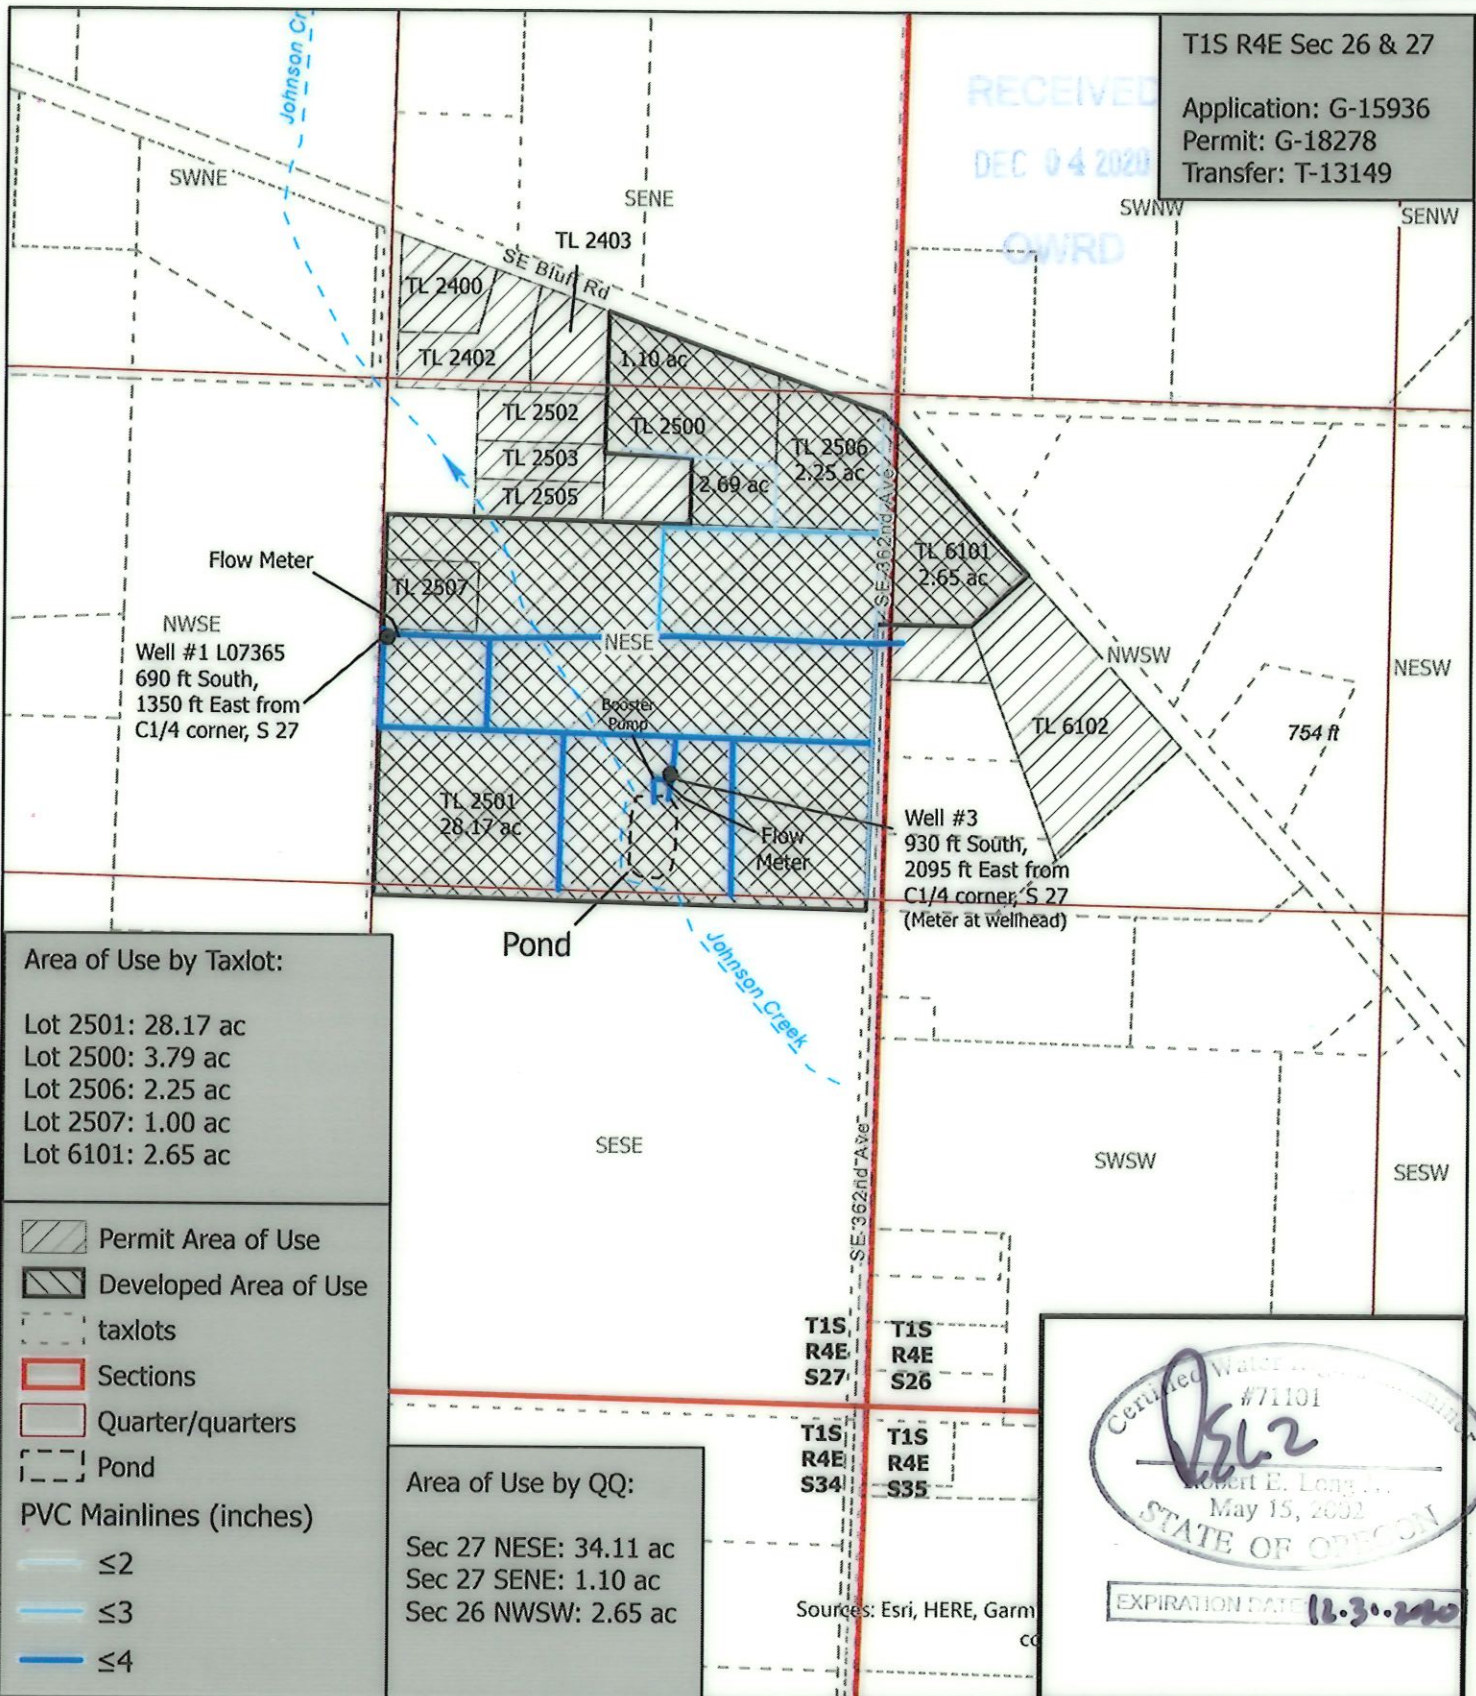

Area of Use by Taxlot:

Lot 2501: 28.17 ac
Lot 2500: 3.79 ac
Lot 2506: 2.25 ac
Lot 2507: 1.00 ac
Lot 6101: 2.65 ac

- Permit Area of Use
- Developed Area of Use
- taxlots
- Sections
- Quarter/quarters
- Pond

PVC Mainlines (inches)

- ≤2
- ≤3
- ≤4

Area of Use by QQ:

Sec 27 NESE: 34.11 ac
Sec 27 SENE: 1.10 ac
Sec 26 NWSW: 2.65 ac

T1S
R4E
S27
T1S
R4E
S26
T1S
R4E
S34
T1S
R4E
S35

Sources: Esri, HERE, Garmin



EXPIRATION DATE 12.31.2020

CwM-H2O
Complete Water Management

1319 SE MLK, Jr. Blvd, Suite 204
Portland, Oregon 97214
(503) 954-1326

This map is not intended to provide legal dimensions or locations of property ownership lines.

1	DATE	AUTH	DRAFT
1	9/16/20	IAG	Draft
2	11/3/20	REL	Comments/Edits
No.	Date	By	Revisions

0 250 500 1,000 ft
Scale: 1" to 500'

Project # 1709002
Trees NW
Trees NW
9720 SE 362nd Ave
Boring, Oregon 97009

