


T.5S. R.1E. Section 2, W.M.

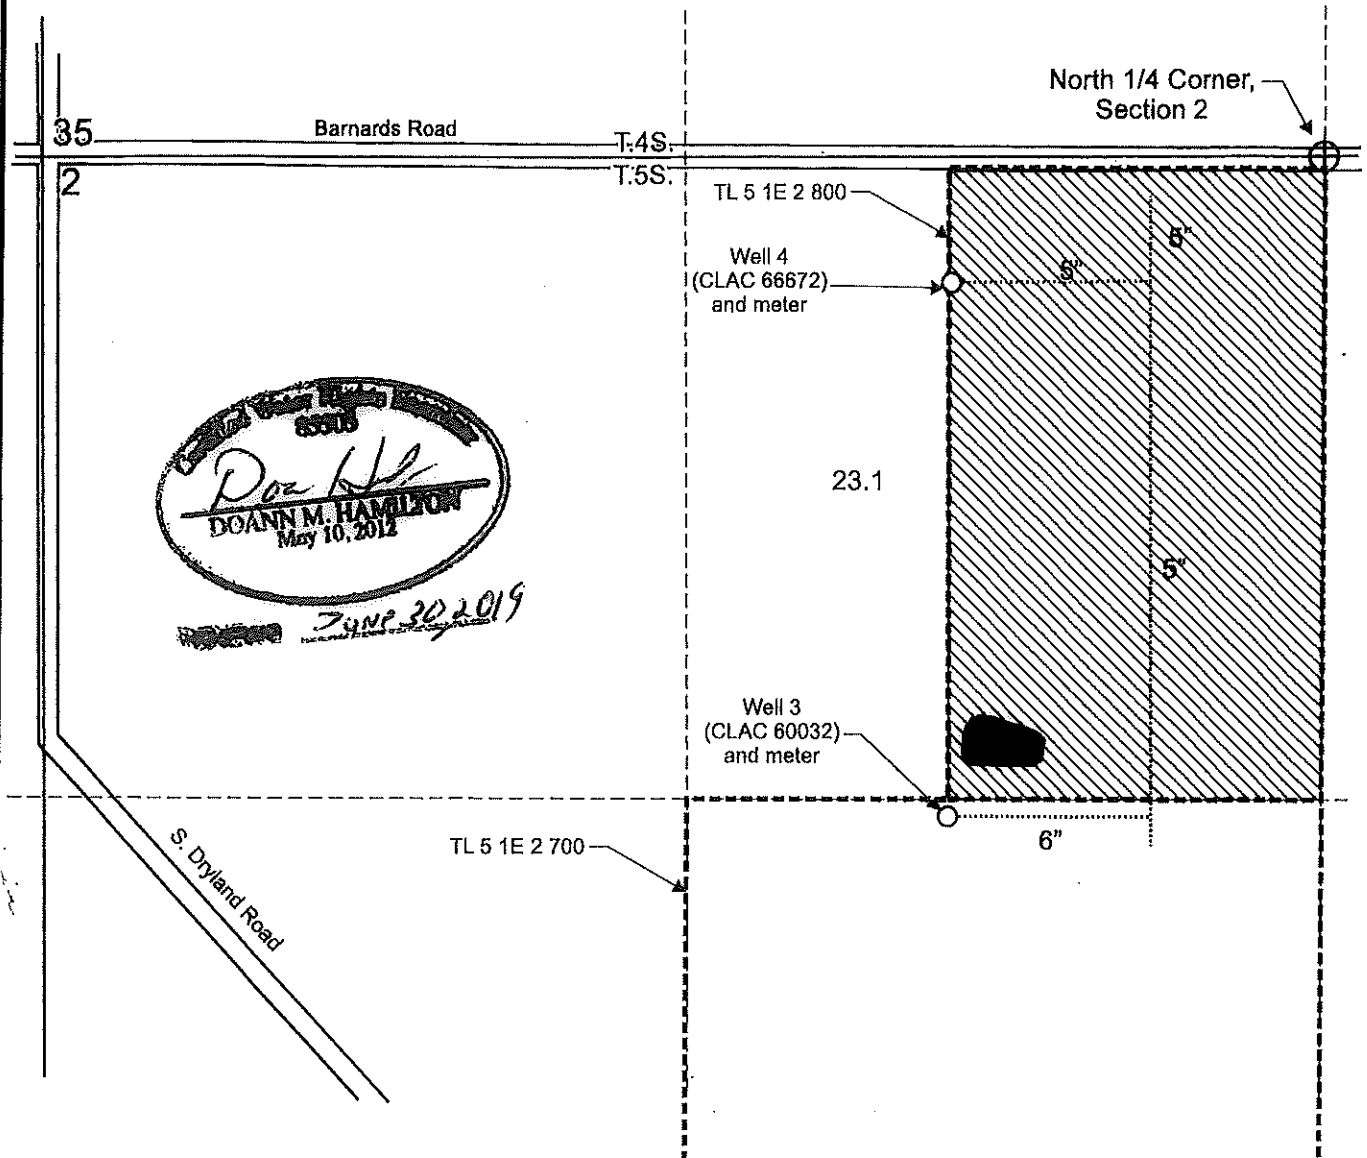

Well 3 (CLAC 60032) is located 1,380 feet south and 720 feet west from the N 1/4 corner, Section 2.

Well 4 (CLAC 66672) is located 280 feet south and 760 feet west from the N 1/4 corner, Section 2.

 Area (23.1 Acres) nursery use under Application G-17099, Permit G-16523.

----- Tax lot boundary

..... Mainlines

Scale: 1" = 400'



This map was prepared for the purpose of identifying the location of a water right only and is not intended to provide legal dimensions or location of property ownership lines.

Claim of Beneficial Use Map
Application G-17099, Permit G-16523

Highland Meadow Nursery Inc.
T.5S., R.1E., Section 2, W.M.

Pacific Hydro-Geology Inc.

06/2019