


Claim of Beneficial Use Map under Permit G-17064
T 37 S, R 4 W, W M, Portion of Section 19, Jackson County
June 1, 2019

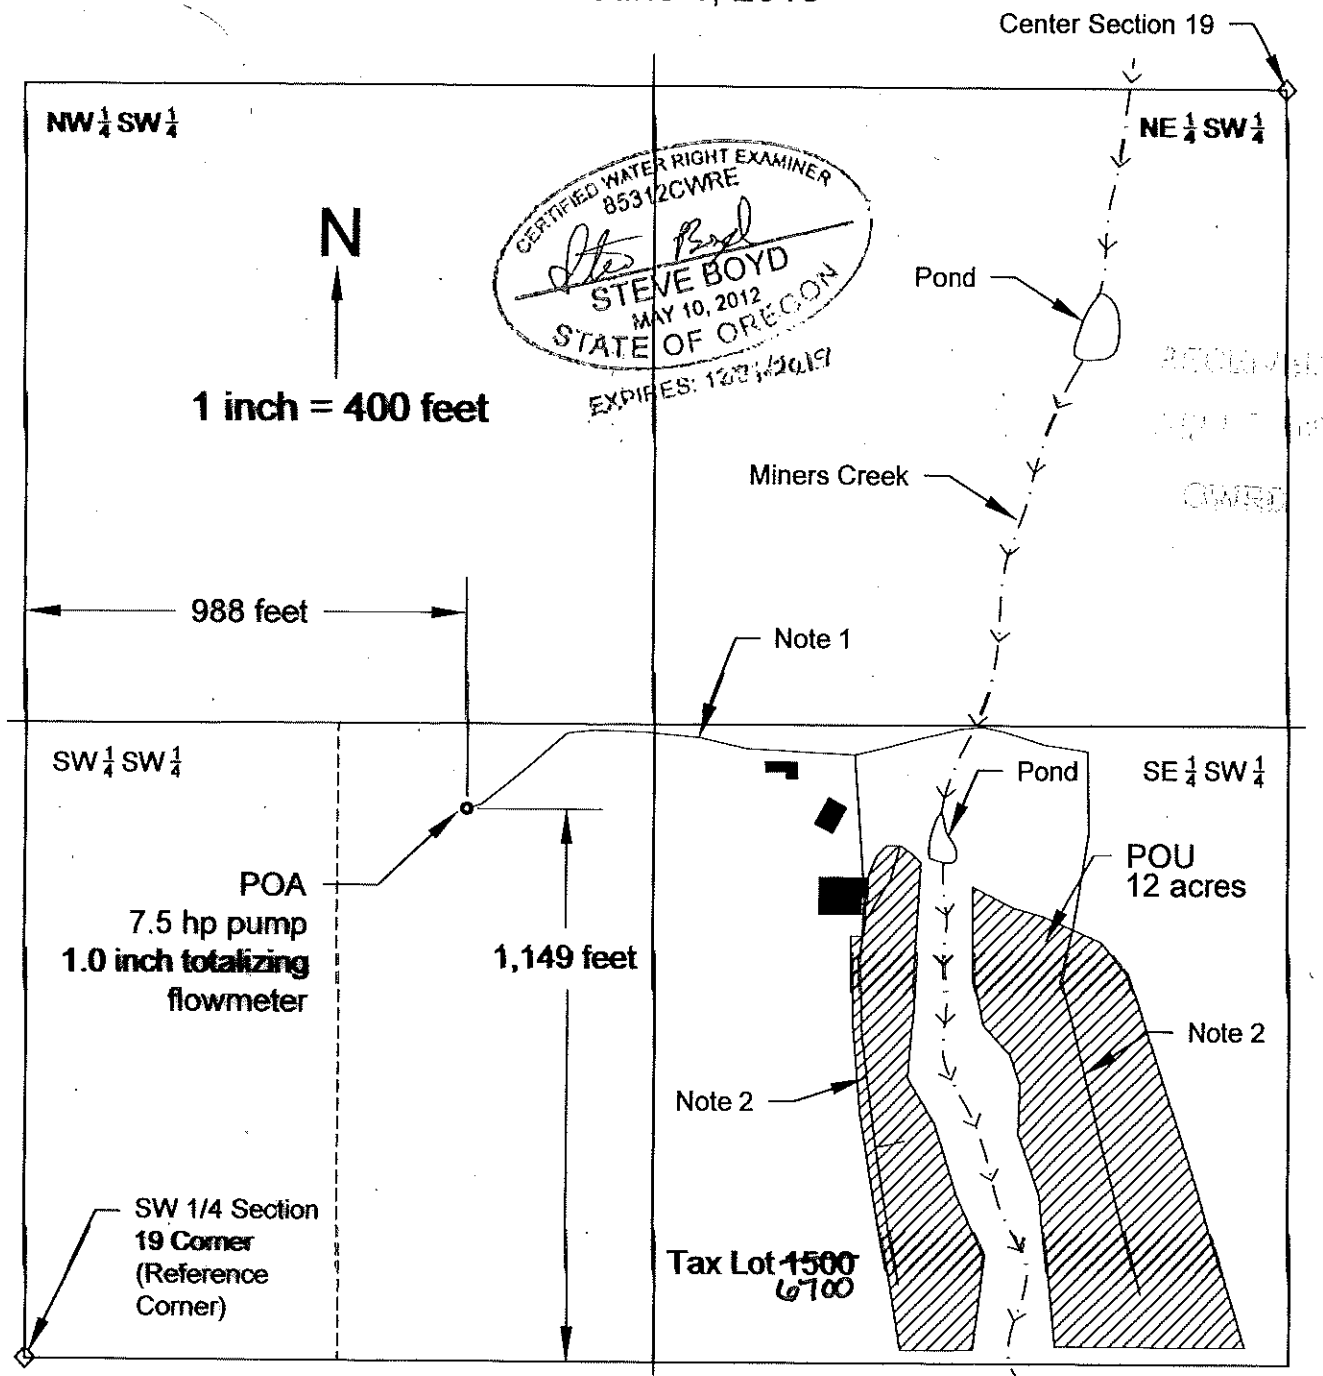

POU (Place of Use) - 12 acres irrigated under Application File No. **G-17591** and Permit **G-17064** with Date of Priority **October 22, 2012**.

POA

Point of Appropriation - Existing ground water well (JACK 61302) is 1,150 feet N and 990 feet E of the SW corner of Section 19.



Structures

Note 1

3.0 inch dia. buried PVC pipe main irrigation line.

Note 2

2.0 inch dia. buried PVC pipe feeding risers, hand lines / pod lines, and sprinklers.

This map was drawn by Steven P. Boyd (CWRE# 85312) in support of Claim of Beneficial Use for irrigation.

NOTE: This map is not intended to provide legal dimensions or locations of property ownership lines.

*OWRD has modified this map
to show correct tax lot.
9/13/OWRD 4-17-25*