

LEE HOLDINGS, LLC
CLAIM OF BENEFICIAL USE EXHIBIT MAP
 MARCH 28, 2022

LOCATED IN
 SECTION 35, TOWNSHIP 11 SOUTH, RANGE 3 WEST AND
 SECTION 2, TOWNSHIP 12S, RANGE 3 WEST, WILLAMETTE MERIDIAN
 LINN COUNTY, OREGON
 APPLICATION G-18141
 PERMIT G-17611

RECEIVED

APR 04 2022

OWRD

LEGEND

---	ROAD
----	TAXLOTS
-----	SECTION AND QTR-QTR SECTION LINES
~~~~~	CREEK
-----	DONATION LAND CLAIM
-----	MAINLINE
●	FOUND MONUMENT
○	WELL

**PLACE OF USE**

**AREA A**  
 31.6 PRIMARY IRRIGATED ACRES NE  
 1/4, SW 1/4, SECTION 35, T.11S  
 R.3W W.M WITHIN DLC 67.

**AREA B**  
 32.2 PRIMARY IRRIGATED ACRES SE  
 1/4 SW 1/4, SECTION 35, T.11S  
 R.3W W.M WITHIN DLC 67.

**AREA C**  
 33.5 PRIMARY IRRIGATED ACRES NE  
 1/4 NW 1/4 SECTION 2, T.12S  
 R.3W W.M WITHIN DLC 38.

**AREA D**  
 26.1 PRIMARY IRRIGATED ACRES SE  
 1/4 NW 1/4 SECTION 2, T.12S  
 R.3W W.M WITHIN DLC 38.

**AREA E**  
 39.5 PRIMARY IRRIGATED ACRES NW  
 1/4 SE 1/4 SECTION 35 T.11S  
 R.3W W.M WITHIN DLC 67.

**AREA F**  
 38.7 PRIMARY IRRIGATED ACRES SW  
 1/4 SE 1/4 SECTION 35, T.11S  
 R.3W W.M WITHIN DLC 67.

**AREA G**  
 40.4 PRIMARY IRRIGATED ACRES NW  
 1/4 NE 1/4 SECTION 2 T.12S R.3  
 W W.M WITHIN DLC 38.

**AREA H**  
 34.9 PRIMARY IRRIGATED ACRES SW  
 1/4 NE 1/4 SECTION 2 T.12S R.3W  
 W.M WITHIN DLC 38.

**AREA I**  
 7.0 PRIMARY IRRIGATED ACRES NE  
 1/4 SE 1/4 SECTION 35 T.11S  
 R.3W W.M WITHIN DLC 67.

**AREA J**  
 6.9 PRIMARY IRRIGATED ACRES SE  
 1/4 SE 1/4 SECTION 35 T.11S  
 R.3W W.M WITHIN DLC 67.

**AREA K**  
 7.2 PRIMARY IRRIGATED ACRES NE  
 1/4 NE 1/4 SECTION 2 T.12S  
 R.3W W.M WITHIN DLC 38.


**AREA L**  
 6.2 PRIMARY IRRIGATED ACRES SE  
 1/4 NE 1/4 SECTION 2 T.12S  
 R.3W W.M WITHIN DLC 38.

**AREA M**  
 4.0 PRIMARY IRRIGATED ACRES NE  
 1/4 SE 1/4 SECTION 35 T.11S  
 R.3W W.M WITHIN DLC 66.

**AREA N**  
 29.7 PRIMARY IRRIGATED ACRES SE  
 1/4 SE 1/4 SECTION 35 T.11S  
 R.3W W.M WITHIN DLC 66.

**AREA O**  
 32.0 PRIMARY IRRIGATED ACRES NE  
 1/4 NE 1/4 SECTION 2 T.12S  
 R.3W W.M WITHIN DLC 37.

**AREA P**  
 29.3 PRIMARY IRRIGATED ACRES SE  
 1/4 NE 1/4 SECTION 2 T.12S  
 R.3W W.M WITHIN DLC 37.

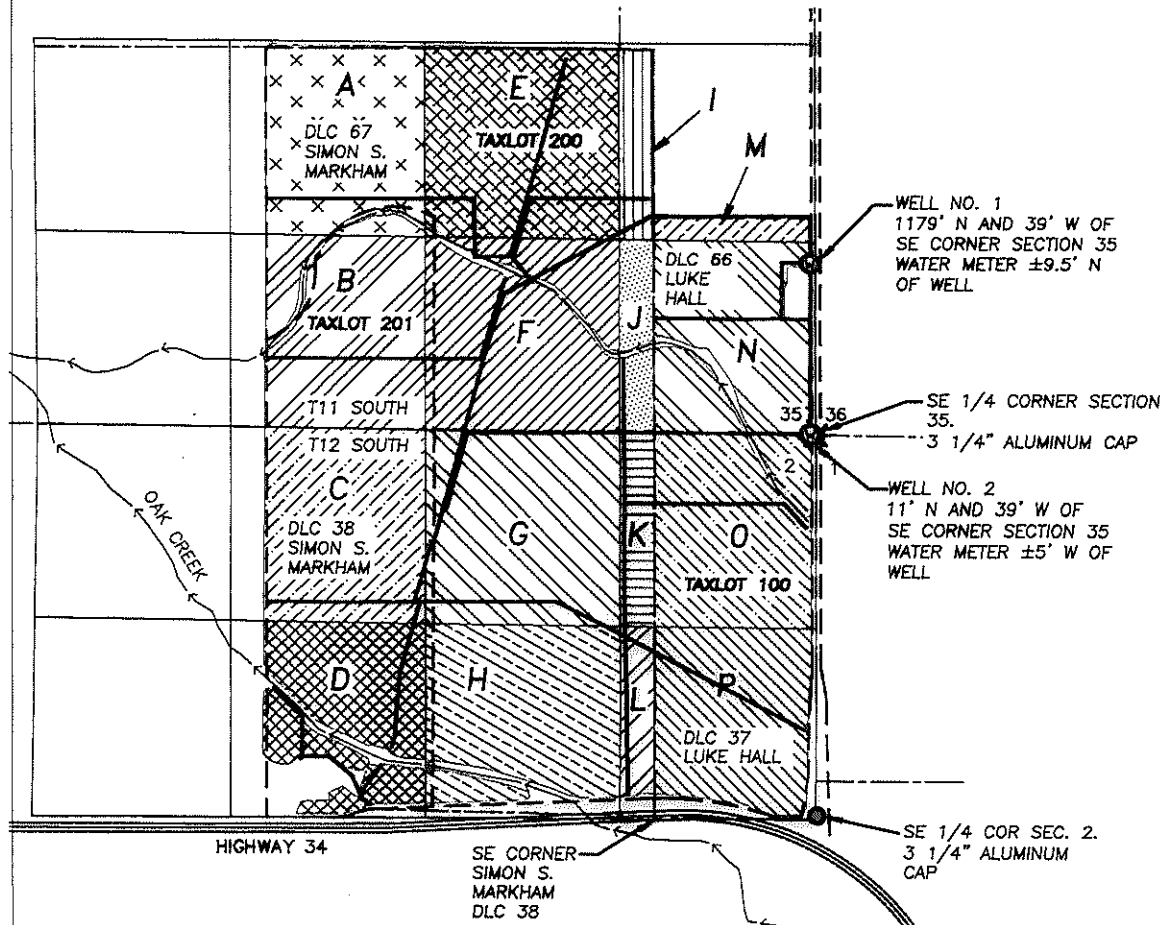

**JDMcGee, Inc.**  
 Engineering & Surveying  
 Land Use Planning  
 Wastewater Design  
 "Solving Problems for You"

1215 Main Street  
 PO Box 1472  
 Philomath, OR 97370  
 (541) 928-4226  
 (541) 928-4227 fax

MAP BASE: TAX ASSESSOR MAP.



POSITIONS OF STRUCTURES RELATIVE TO SE  
 CORNER OF SECTION 35 ARE BASED ON A GPS  
 SURVEY.

THIS MAP IS NOT INTENDED TO PROVIDE LEGAL  
 DIMENSIONS OR LOCATION OF PROPERTY  
 OWNERSHIP LINES.

DRAWN BY: TB CHECKED BY: JDM  
 JDM PROJECT #: 20-31



SCALE: 1" = 1320'

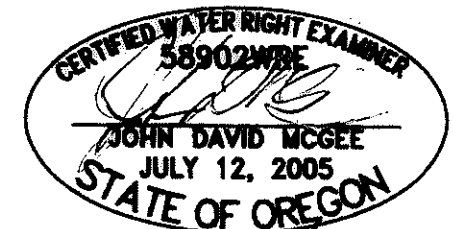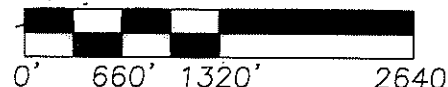

RENEWS: 12/31/2022