

CHOSEN VENTURES LLC
1999 EAGLE MILL RD
ASHLAND, OR 97520

PERMIT G-17760
APPLICATION G-18283
SITUATED IN
SECTION 33, TOWNSHIP 38 S RANGE
1 E, W.M.
JACKSON COUNTY OREGON

CLAIM OF BENEFICIAL USE
GROUND WATER RIGHT

● JACK 63241 and METER
650' NORTH and 675' WEST OF SE 1/4 CORNER
SECTION, 33 T38S R1E

IRRIGATION - 52.2 ACS TOTAL

17.0 ACS NE SE
4.4 ACS NW SE

RECEIVED

JUL 03 2023

OWRD



18.3 ACS SW SE (LOT 8)




12.5 ACS SE SE (LOT 9)


— — PIPELINE



TANKS

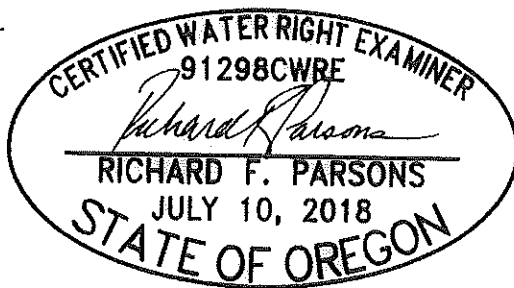

200
NWSE

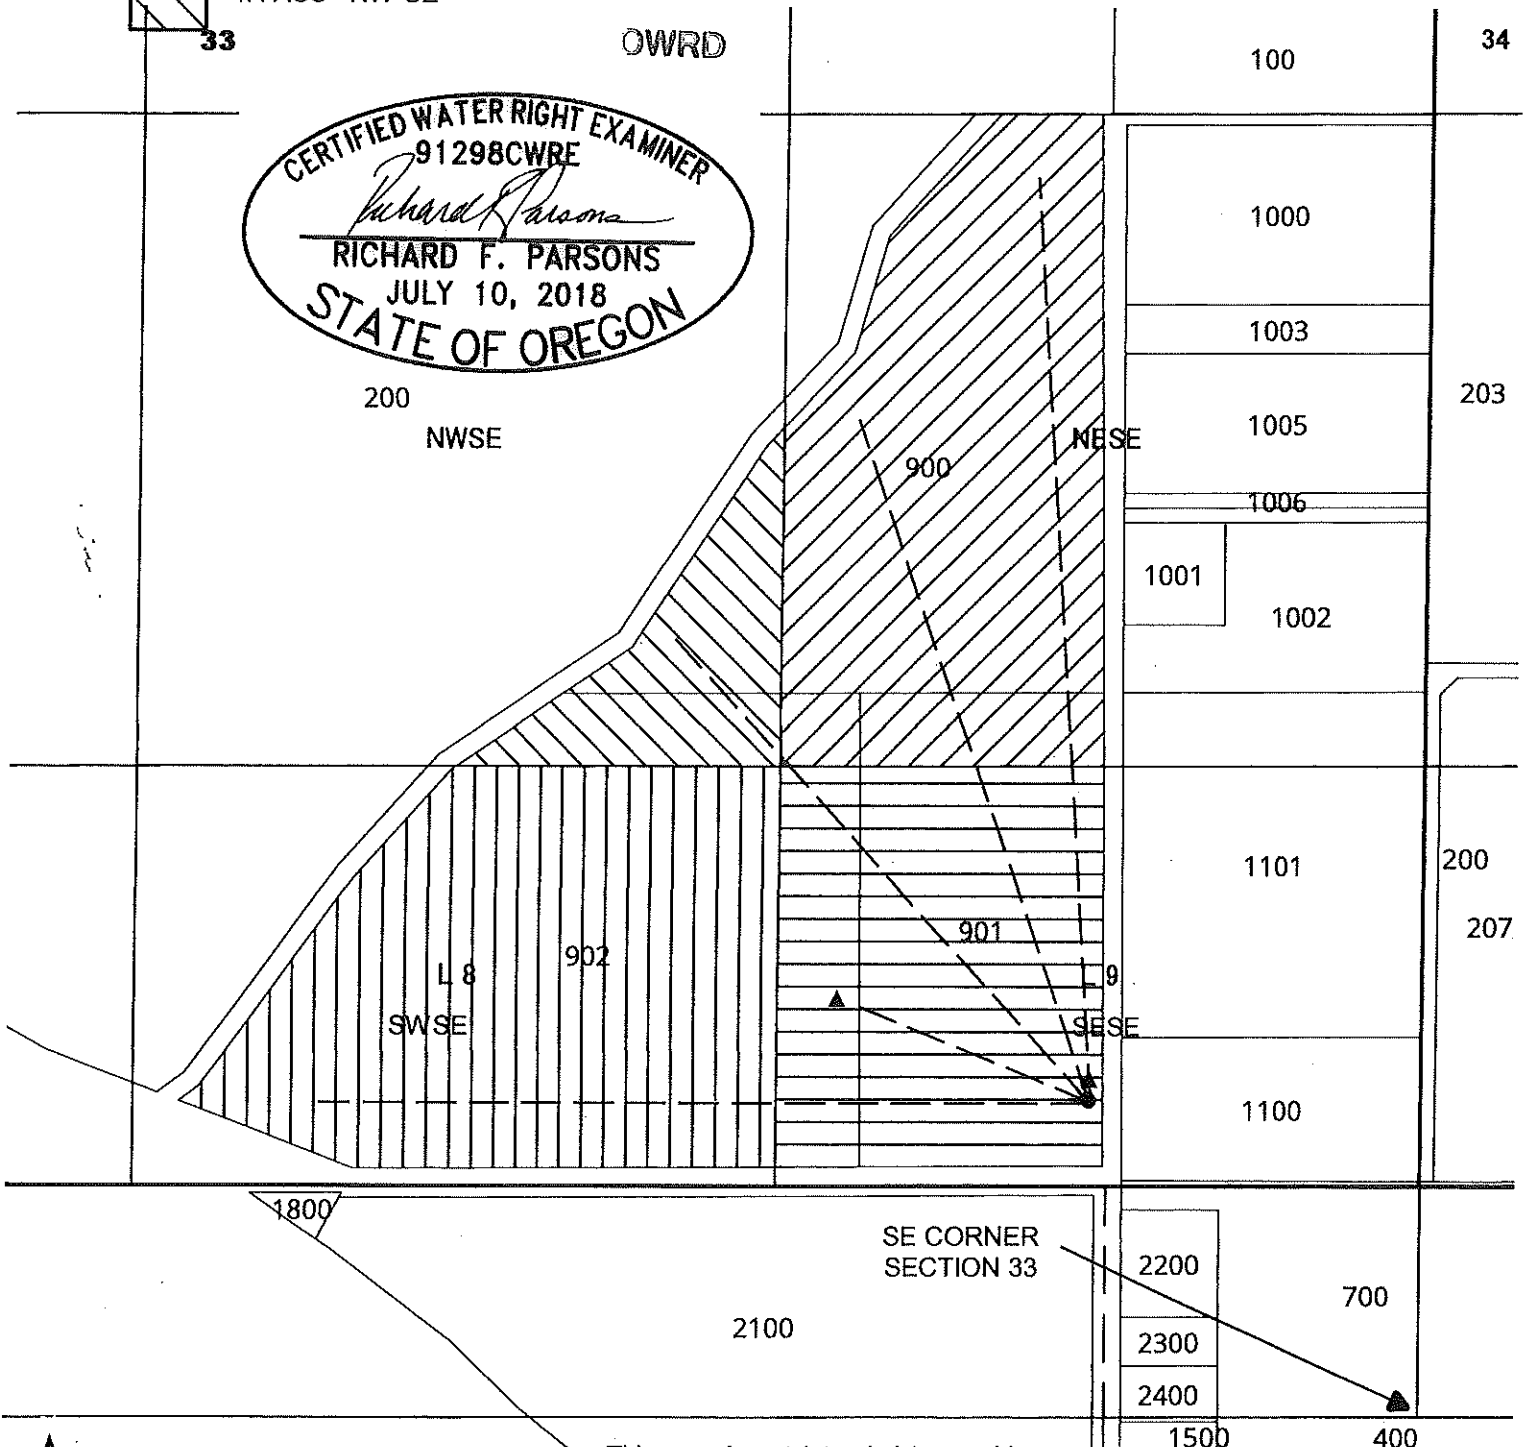

SE CORNER
SECTION 33

2100

2200
2300
2400

700

1500

400



0 400 ft

This map is not intended to provide
legal dimensions or locations of
property ownership lines

ParsonsWater Consulting LLC
rick.parsons@parsonwater.com