


Claim of Beneficial Use - Lorenzen

Application S-88522, Permit S-55177

Township 4S, Range 3W, W.M.

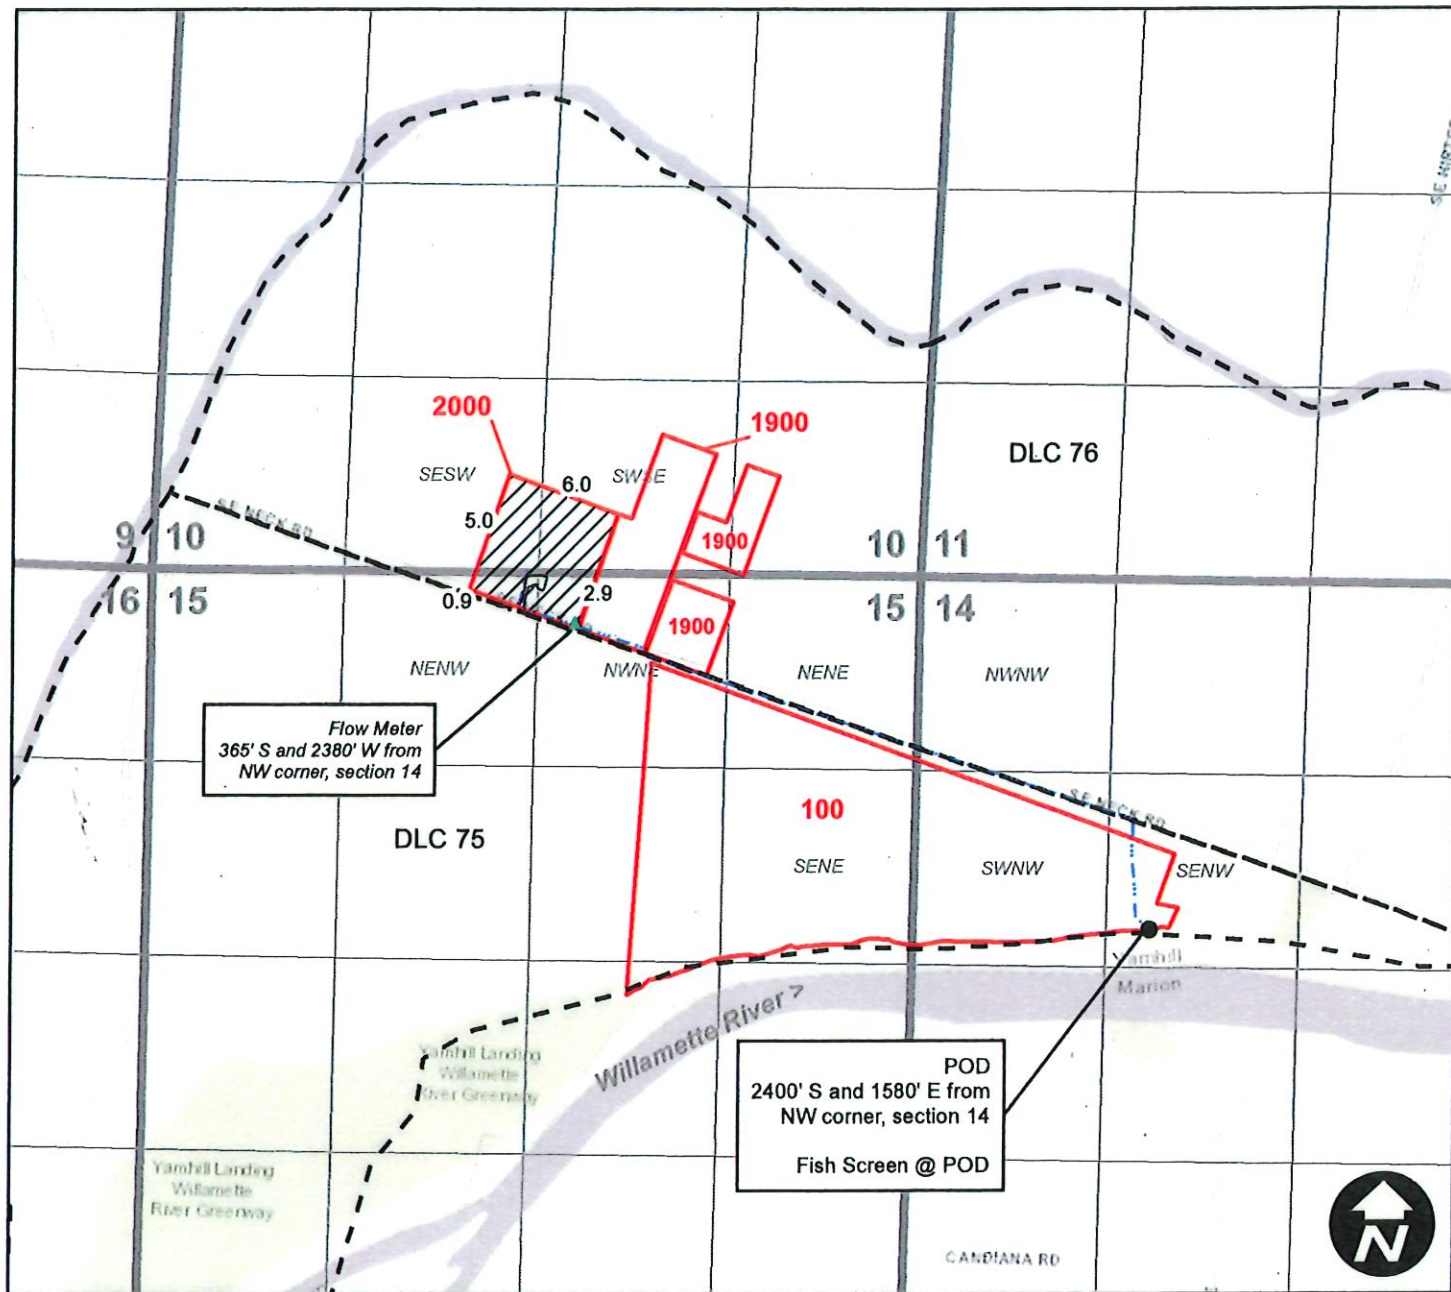

0 660 1,320 2,640 Feet

This map is not intended to provide legal dimensions or locations of property ownership lines.

Legend

- POU
- Flow Meter
- DLC
- Taxlot
- Mainline

RECEIVED



EXPIRES: 12-31-2022