


T.6S. R.1&2W. Section 7, 12, & 13, W.M.

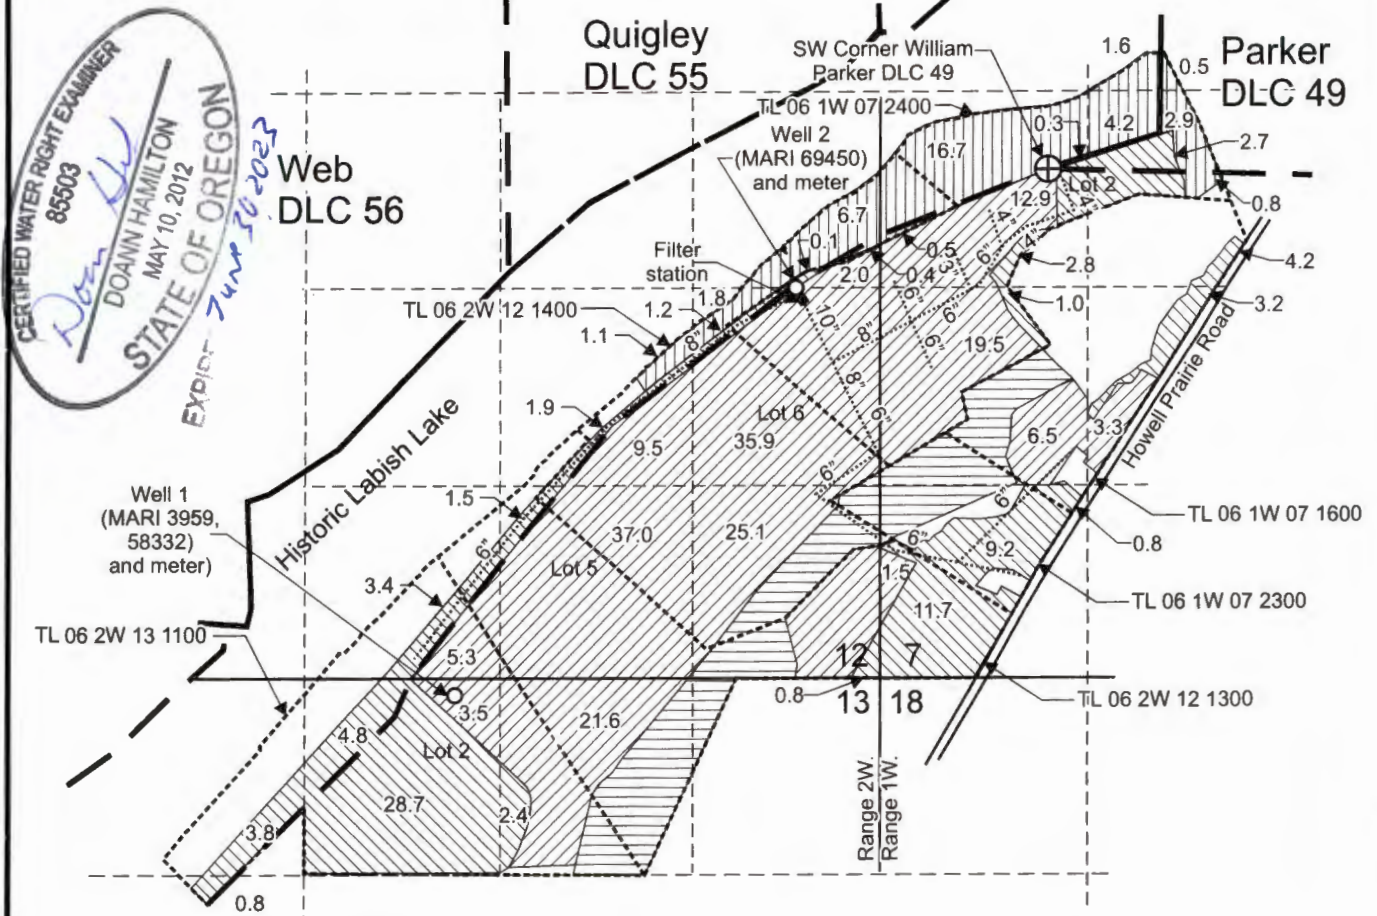

Well 1 (MARI 3959, 58332) is located 115 feet south and 2,925 feet west from the NE corner, Section 13.

Well 2 (MARI 69450) is located 800 feet south and 1,690 feet west from the SW corner, William Parker DLC 49.

-  Area (85.3 acres) primary irrigation under Application G-15722, Permit G-15990.
-  Area (37.2 acres) of primary irrigation area on NRCS easement under Application G-15722, Permit G-15990.
-  Area (183.6 acres) of supplemental irrigation under Application G-15722, Permit G-15990.
-  NRCS easement within supplemental irrigation area under Application G-15722, Permit G-15990, not irrigated.
-  Tax lot boundary
-  Donation Land Claim boundary
-  Water main line (buried and above ground)

Scale: 1" = 1,320'



This map was prepared for the purpose of identifying the location of a water right only and is not intended to provide legal dimensions or location of property ownership lines.

Claim of Beneficial Use Map
Application G-15722, Permit G-15990, T-10412

Wagenbach PNW LLC / Stor-Moore LLC,
Joseph Cox and Hilary Rich


Pacific Hydro-Geology Inc.

10/2022

RECEIVED

NOV 10 2022

OWRD

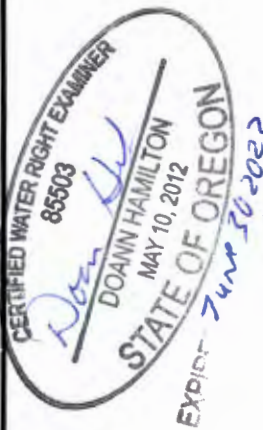

T.6S. R.1W. Sec. 7, R.2W. Sec. 12 & 13, W.M.


- . Donation Land Claim boundary
- - - - Tax lot boundary
- Water main line (buried and above ground)

Quigley
DLC 55

SW Corner William
Parker DLC 49

Parker
DLC 49

Web
DLC 56

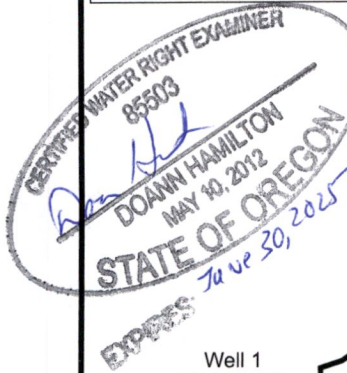

Well 1
(MARI 3959,
58332)
and meter)

TL 06 2W 13 1100

Historic Labish Lake

Filter
station

Well 2
(MARI 69450)
and meter

Lot 6

Lot 5

Lot 2

Lot 1

Lot 4

Lot 3

Lot 7

Lot 8

