


T. 18 & 19 S., R. 46 E., W.M.

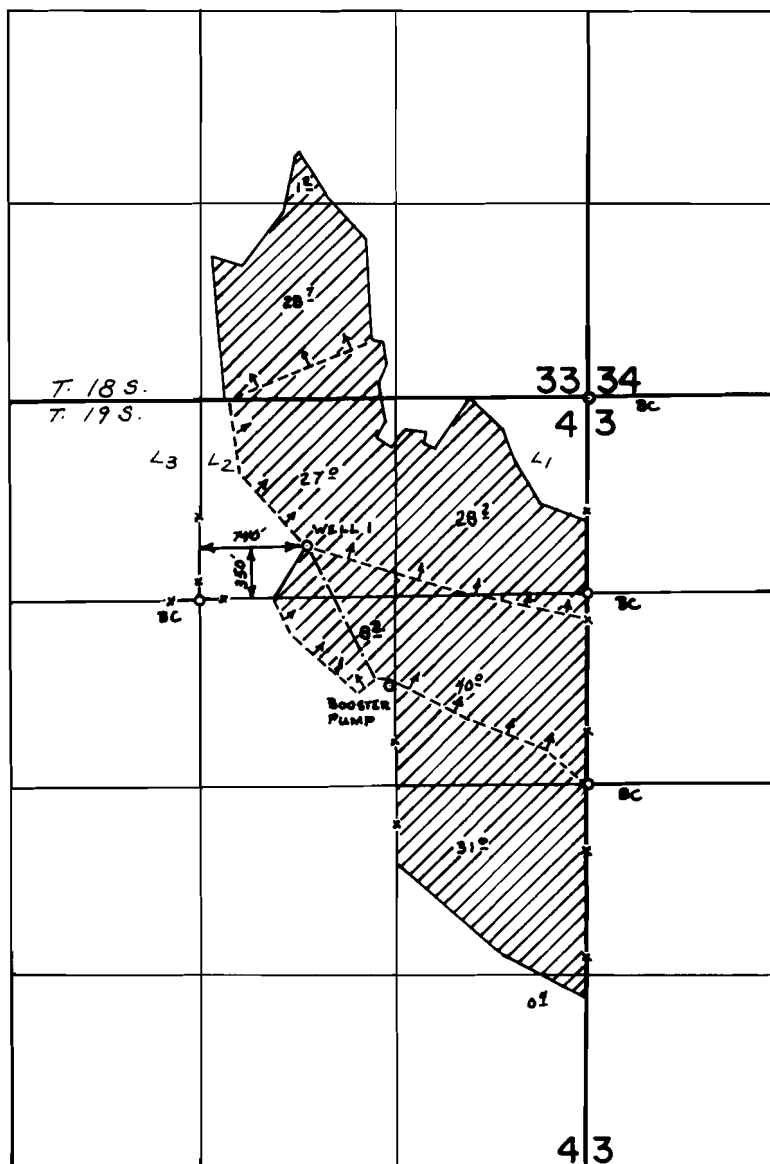

FINAL PROOF SURVEY
UNDER

Application No. G-5631 Permit No. G-5463
IN NAME OF

RAYMOND FINDLEY

Surveyed OCT. 15 1977, by J.S.DONALDSON

