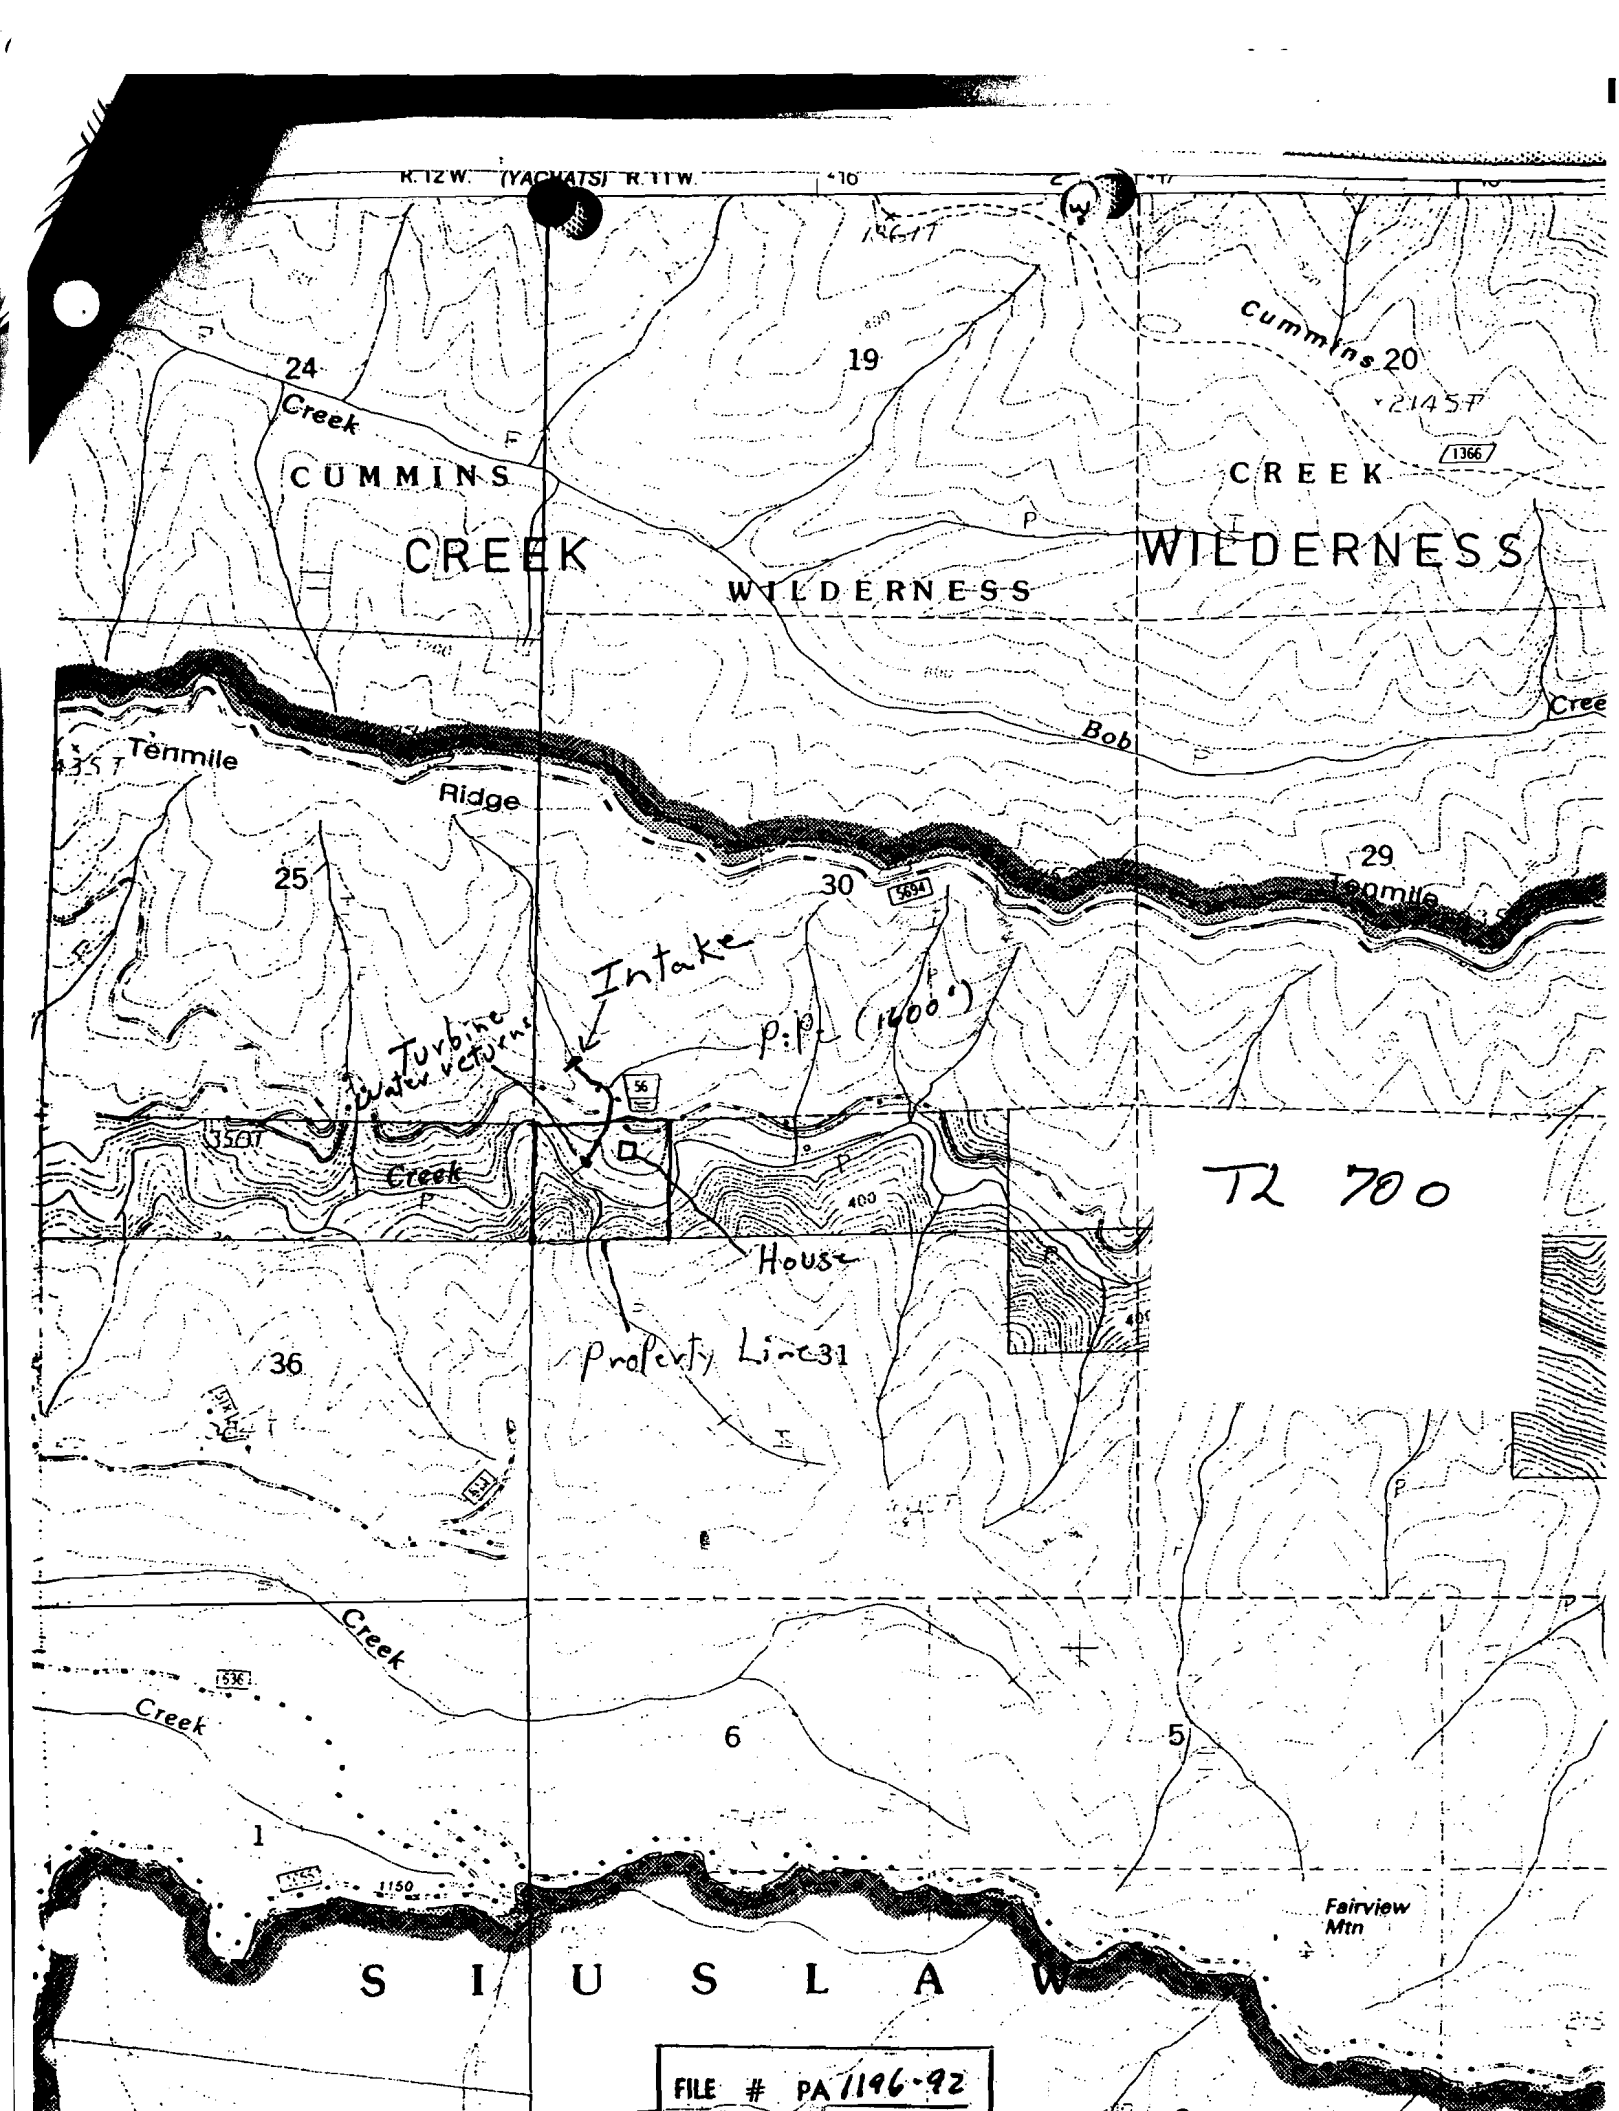
CUMMINS CREEK WILDERNESS
CUMMINS CREEK WILDERNESS
Cummins
Creek
Tenmile Ridge
Bob
Tenmile
Intake
Water Turbine returns
p.l. (1400')
House
Property Line
T2 700
Creek
Creek
Creek
SIUSLAW
Fairview Mtn
24
19
20
25
30
29
36
31
6
5
1
1366
1150
FILE # PA 1196-92