

LOCATION DESCRIPTION

POD 1 (Reservoir 1)

Located 1155 feet South and 870 feet West from the Northerly corner of DLC 66, Township 9 South, Range 5 West (W.M.)

POD 2 (Reservoir 3)

Located 1350 feet North and 220 feet West from the SE corner of Section 32, Township 9 South, Range 5 West (W.M.)

POD 3 (Reservoir 4)

Located 2795 feet North and 720 feet East from the Northerly corner of DLC 66, Township 9 South, Range 5 West (W.M.)

POD 4 (Reservoir 5)


Located 720 feet South and 1900 feet West from the Northerly corner of DLC 66, Township 9 South, Range 5 West (W.M.)

POD 5 (Reservoir 7)

Located 150 feet North and 310 feet West from the SE corner of Section 32, Township 9 South, Range 5 West (W.M.)

POD 6 (Reservoir 8)

Located 270 feet South and 20 feet West from the Northerly corner of DLC 66, Township 9 South, Range 5 West (W.M.)

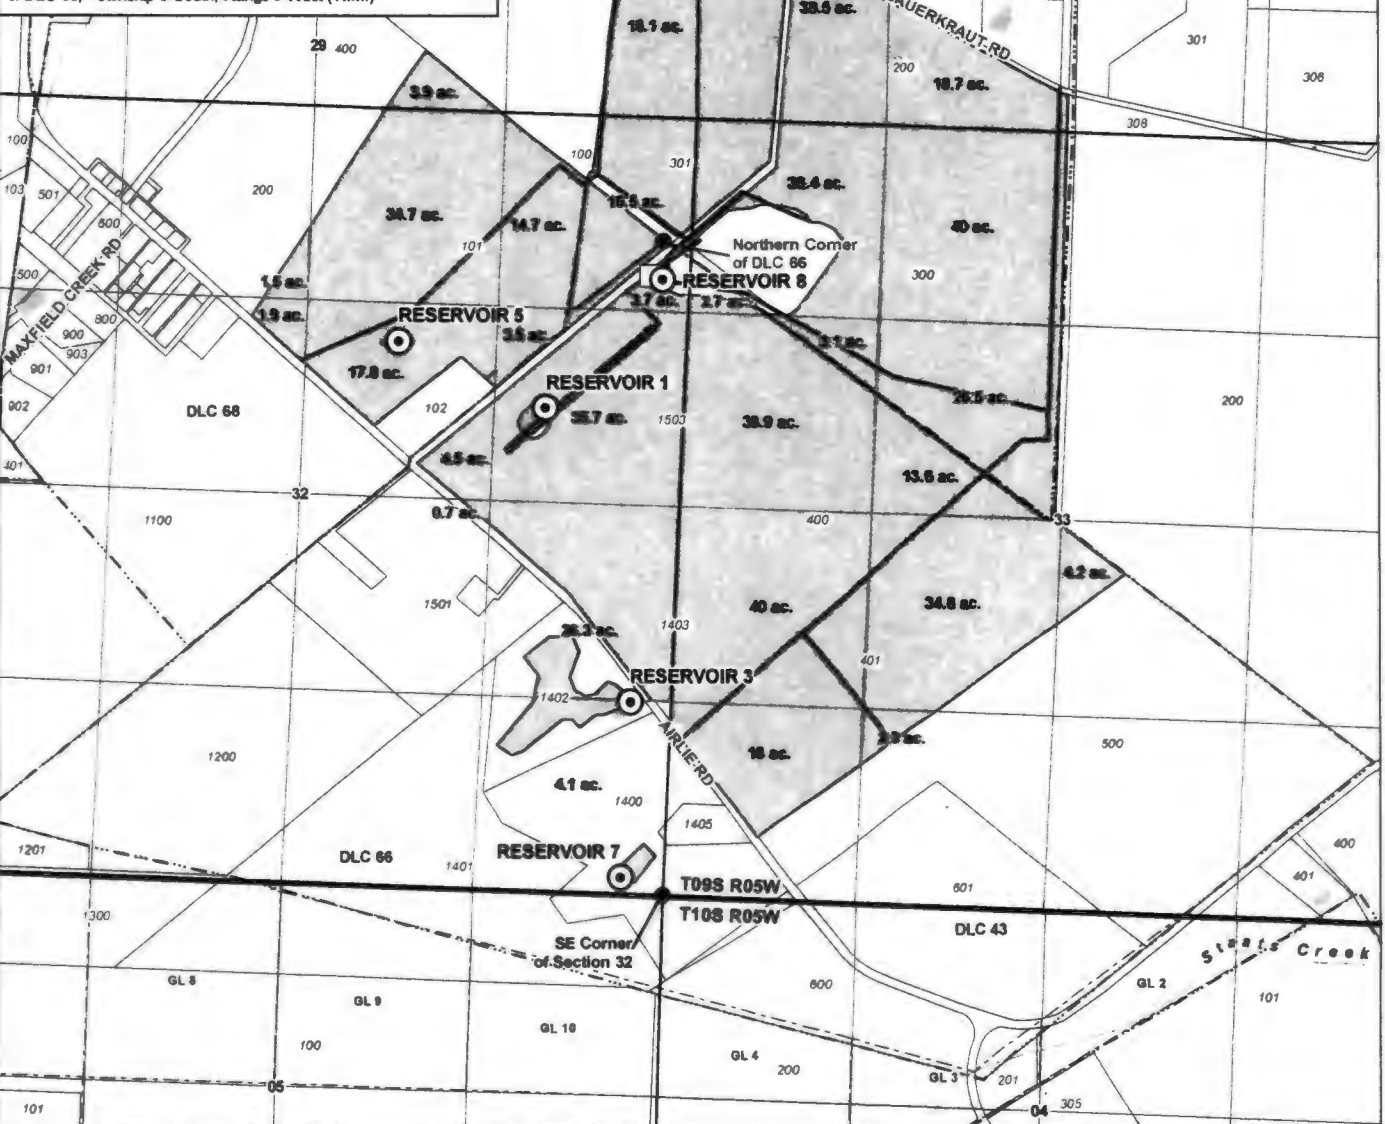

LEGEND

- ⊙ Point of Diversion (POD)
- Meter
- Conveyance
- Place of Use (POU)
- Government Lot (GL)
- Donation Land Claim (DLC)
- Tax Lot
- Watercourse
- Waterbody


DISCLAIMER

This map was prepared for the purpose of identifying the location of a water right only and it is not intended to provide legal dimensions or location of property ownership lines.

Date: September 19, 2023

Data Sources: BLM, ESRI, OWRD, USGS, Polk Co.

CERTIFIED WATER RIGHTS EXAMINER STAMP

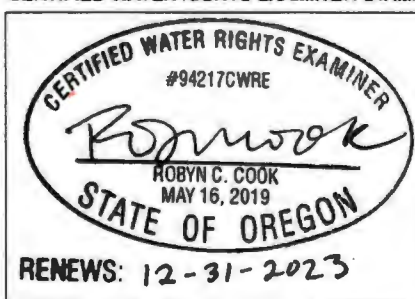

Claim of Beneficial Use in the Name of Hamilton Farms, LLC

Application S-88482, Permit S-55129

Polk County
Township 9, 10 South,
Range 5 West (W.M.)

OCT 04 2019

COUNTY



0 660 1,320
1 inch = 1,320 feet

