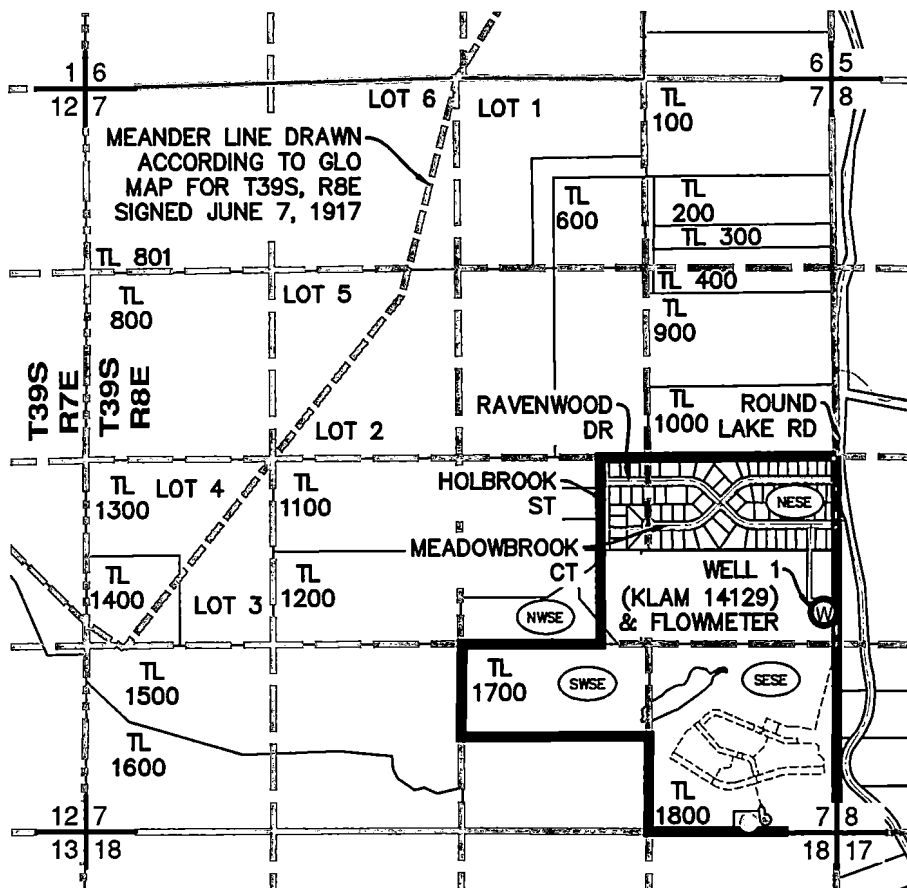


LEGEND


	RANGE LINE
	SECTION LINE
	1/4 1/4 LINE
	GLO MEANDER LINE
	TAX LOT LINE
	BURIED 6" PVC PIPE
	ROAD
	SECTION CORNER
	TAX LOT NUMBER
	GOVERNMENT LOT NUMBER
	POA (WELL)
	BOOSTER PUMP
	STORAGE TANK
	1/4 1/4 SECTION OF WATER USE
	QUASI-MUNICIPAL USE BOUNDARY

NOTES:

1. THIS MAP WAS PREPARED FROM FIELD MEASUREMENTS, NAIP 2022 AERIAL PHOTOGRAPH, KLAMATH COUNTY TAX MAPS, AND OREGON GLO MAPS.
2. THE PURPOSE OF THIS MAP IS TO IDENTIFY THE LOCATION OF THE WATER RIGHT ONLY, AND IS NOT INTENDED TO PROVIDE DIMENSIONS OR LOCATION OF PROPERTY LINES.
3. DATE OF PRIORITY FOR THIS PERMIT IS DECEMBER 7, 1989.

WELL LOCATION:

WELL 1 (KLAM 14129): 1055' SOUTH & 94' WEST FROM THE EAST 1/4 CORNER OF SECTION 7.

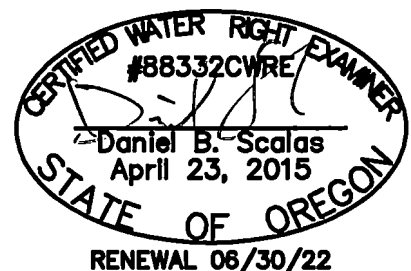

RENEWAL 06/30/22

AL ADKINS
ENGINEERING & SURVEYING

o / 541.884.4666
w / AdkinsEngineering.com

1435 ESPLANADE AVENUE, KLAMATH FALLS, OR 97601

SERVING S. OREGON & N. CALIFORNIA

ENGINEERING • SURVEYING • PLANNING • TESTING

CLAIM OF BENEFICIAL USE AND FINAL PROOF MAP

FOR

ROUND LAKE MHP LLC
T39S, R8E, SEC. 7, WM
KLAMATH COUNTY, OREGON
PERMIT G-11079
APPLICATION G-11994