


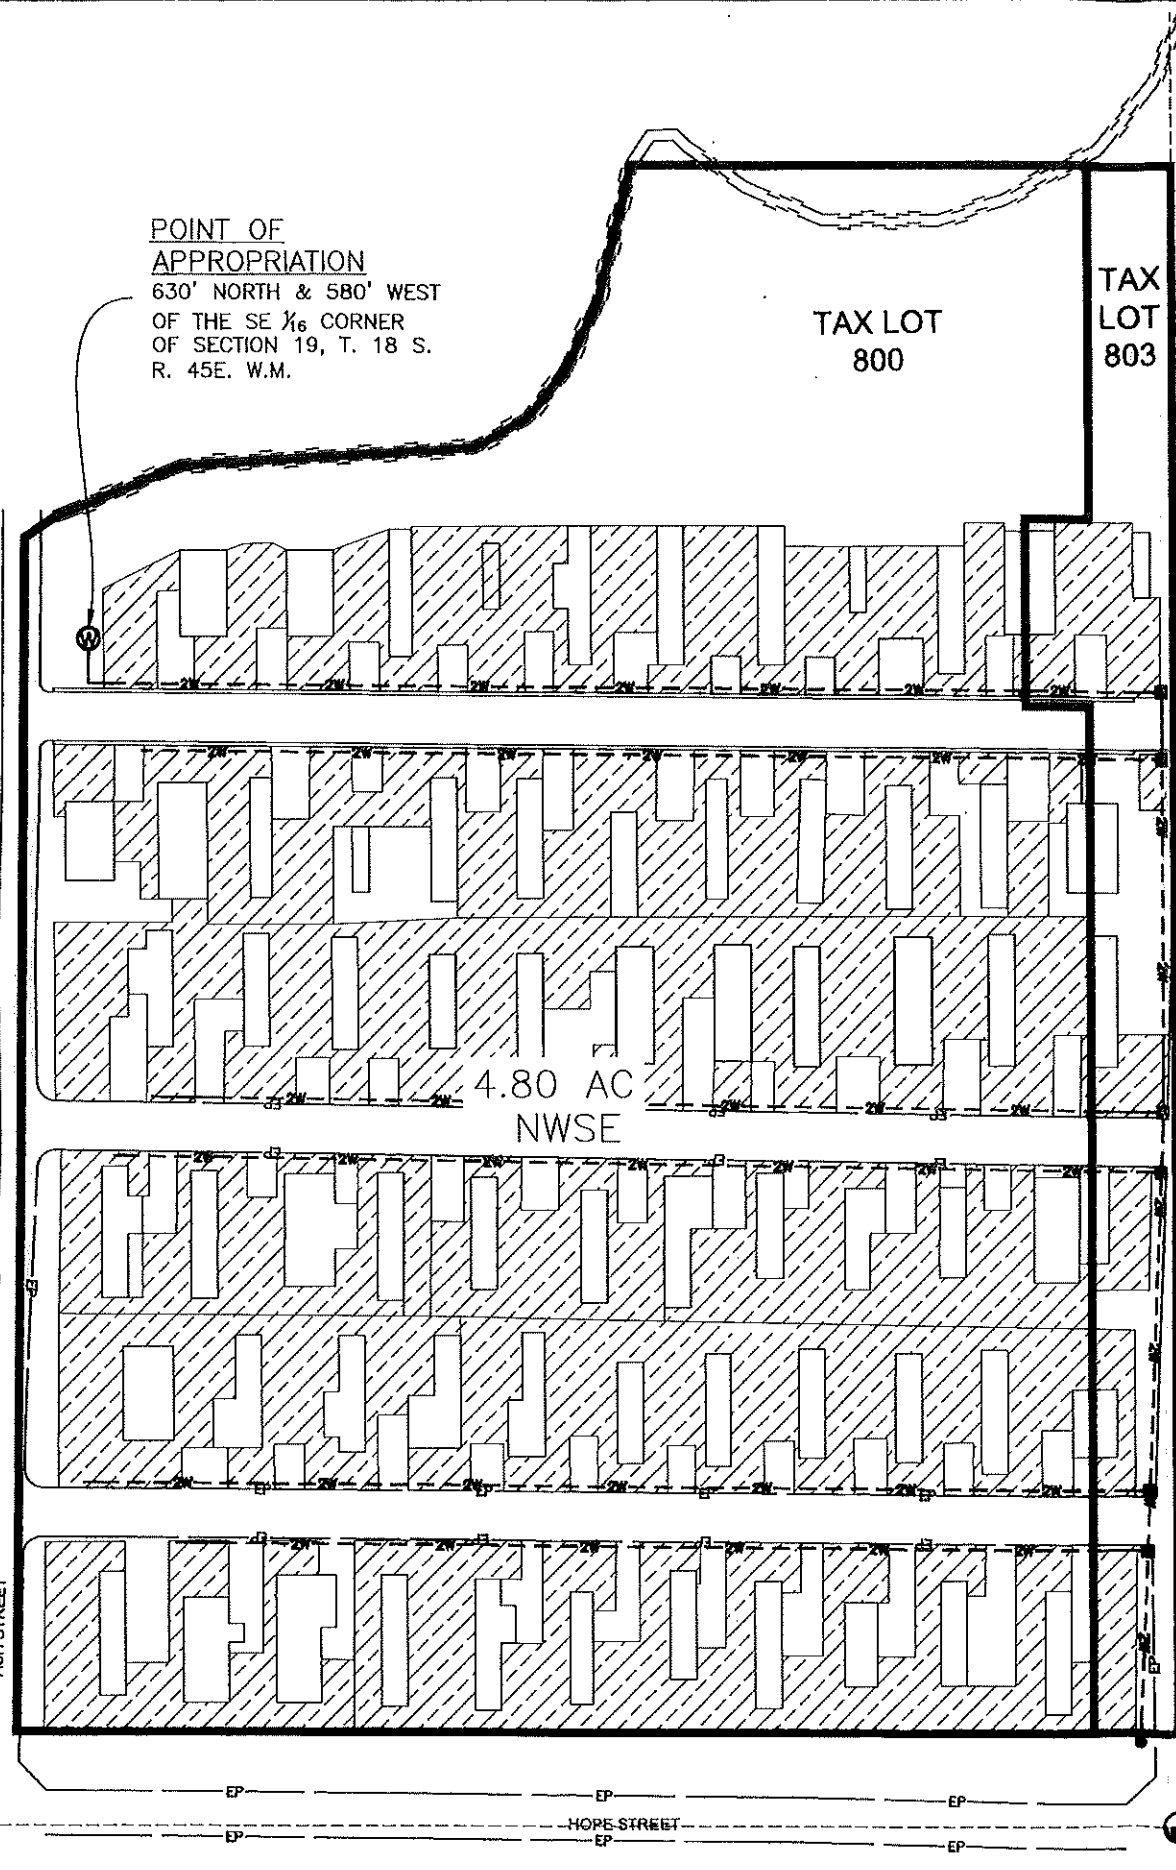

LEGEND	
DESCRIPTION	SYMBOLS
SECTION CORNER	
RECOGNIZED SURVEY CORNER	
POINT OF APPROPRIATION	
WATER VALVE BOX	
SECTION LINE	
QUARTER-QUARTER LINE	
TAX LOT LINE	
CANAL or RIVER	
IRRIGATED LANDS	
	4.80 ACRES

RECEIVED
MAY 19 2021
OWRD

Certified Water Right Examiner
#36234WRE
STEWART R. EDWARDS
JULY 24, 2000
STATE OF OREGON
SEALED 5/17/2021

DISCLAIMER:
THIS MAP WAS MADE TO BE PART OF THE CLAIM OF BENEFICIAL USE FOR A WATER RIGHT. SECTIONAL LINES SHOWN ARE APPROXIMATE AND THIS MAP IS NOT INTENDED FOR ANY OTHER USE AND DOES NOT GUARANTEE LAND OWNERSHIP.

Reviewed By: PAT J. WOODCOCK
Drawn By: PJW
Print Date: MAY 17, 2021
DWG. Scale: AS SHOWN

CLAIM OF BENEFICIAL USE MAP
for PERMIT G-16668
Sec. 19, T. 18 S., R. 45 E., W.M.
VALE, MALHEUR COUNTY, OREGON
TREASURE VALLEY MANAGEMENT LLC
1000 Hope Street 43
VALE, OREGON 97918

ENGINEERING
NORTHWEST, LLC
11 NW 9th Street
Ontario, Oregon 97914
www.engineeringnw.com (541)889-4432

W1
SHEET NO. 1 OF 1
JOB NO. 21-022