


Cyrk Building, Low Temperature Open-Loop Geothermal System

Property Tax Lot: 11400


Multnomah County, OR

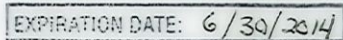

SE Corner James B. Stephens Donation Land Claim (DLC) #53

and SW Corner Seldon Murray DLC #54

Note: I-1 has UIC code #14063-1, type 5A7,
is 112.45 feet west and 668.75 feet south of
SE Corner James B Stephens DLC #53 and
SW Corner Seldon Murray DLC #54

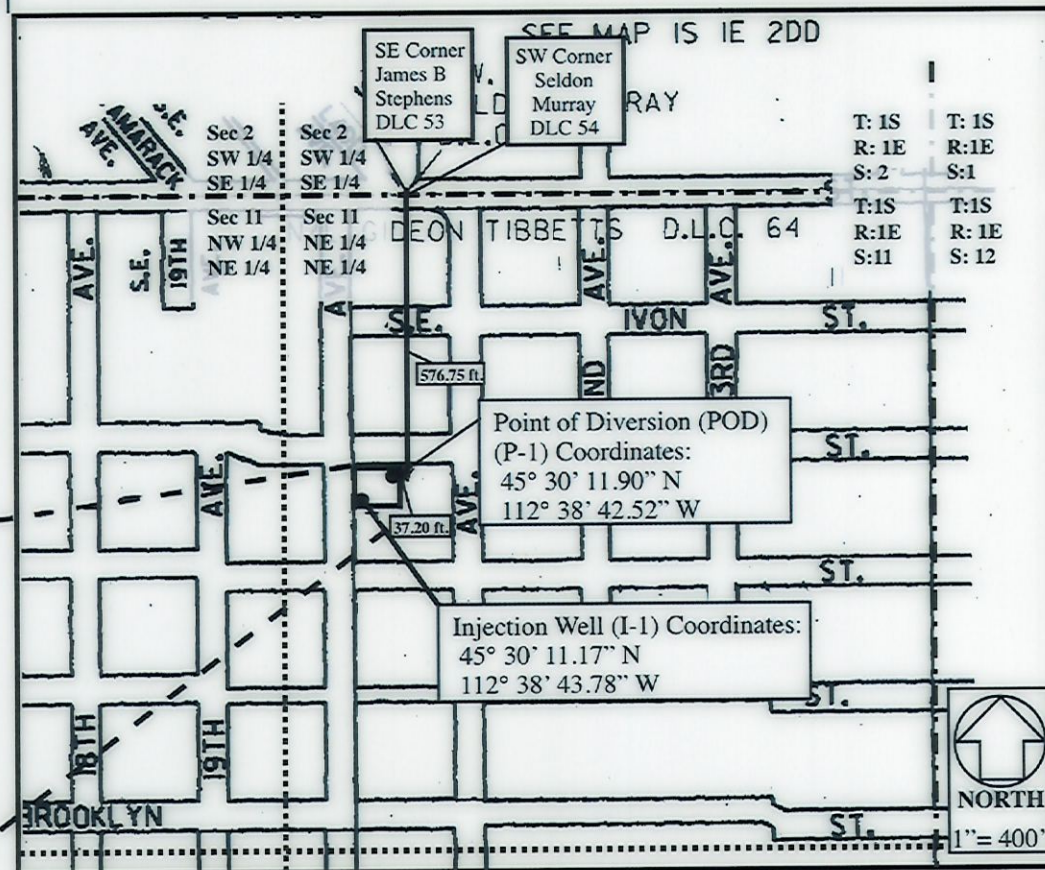

Disclaimer:

This map is not intended to provide legal dimensions or locations of property ownership lines

